

LAND CORNER RECORDATION CERTIFICATE
Filing Requirement of Act 74, Mich. P.A. 1970

1952

LIBER 20945 PAGE 547
\$7.00 MISC RECORDING
\$2.00 REMONUMENTATION
01/04/2000 07:37:46 A.M. RECEIPT# 342
PAID RECORDED - OAKLAND COUNTY
G. WILLIAM CADWELL, CLERK/REGISTER OF DEEDS

RECORDED
9-8-99 JIL
REGISTER OF DEEDS STAMP & FILE NUMBER

For corners in

Oakland Located In: Corner Code #
(county)
Holly Township
1. Public Land Survey T 5N R 7E G-1
T ___ R ___
T ___ R ___
2. Property Controlling S ___ T ___
In Section S ___ T ___
3. Miscellaneous S ___ T ___
Property in Sec. S ___ T ___ R ___

SURVEY &
REMONUMENTATION
MAR 21 2000

SECTION

4. Lot No. _____, Recorded Plat _____
5. Private Claims _____

I, James E. Kovas, in a field survey on December 16, 1999, do hereby certify that under requirements of P.A. 74, Michigan P.A. of 1970, the corner points mentioned in lines 1 and 2 above were in conformance with regulations and rules therefore as required in the current manual of survey instructions of the United States Department of the Interior, Bureau of Land Management or by a decree of a Court of Law and/or that the corner points mentioned in lines 3, 4 and 5 above were in conformance with the rules of the Michigan Board of Land Surveyors or by a Decree of a Court of Law; established, re-established, monumented, re-monumented, recovered, found as expressed below:

NOTE: Not more than 4 corners, all in the same town and range, may be recorded on this certificate.

A. Description of original monument and accessories and/or subsequent restoration:

G-1
1816 - G.L.O., Alex Holmes, D.S., post set

Distances: G-1 to F-1 = 2608.80' (Wade-Trim, 1999)
G-1 to F-1 = 2609.07' (Newman, 1997)
G-1 to F-1 = 2608.28' (Anderson, 1973)
G-1 to H-1 = 2642.51' (Wade-Trim, 1999)
G-1 to G-2 = 2961.78' (Wade-Trim, 1999)
G-1 to G-2 = 2970.00' (45 chains GLO)
G-1 to G-13 Grand Blanc = 4.91' east (Wade-Trim, 1999)
G-1 to G-13 Grand Blanc = 5.94' east (9 links GLO)

B. Description of corner evidence found and/or method applied in restoring or reestablishing corner:

G-1 Found 1/2" iron.

An iron pin was found at the NE corner of 1.1 acre parcel
WITNESSES FOUND:


N 60 E 55.95' to 4" Birch found 56.11'
N 10 W 16.95' to gate post found 16.20'
N 70 E 56.11' to 12" Ash found 56.11'
N 10 E 21.24' to steel post found 21.40'

C. Description of monument for corner and accessories established to perpetuate locating the position of the corner:

G-1 Found 1/2" iron in centerline Holly Road. Removed and replaced with 5/8" iron in monument

WIT: N 31 W 120.00' In NE face power pole
N 27 E 130.05' NW face power pole
S 19 E 108.63' West face 16" Maple

	A	B	C	D	E	F	G	H	I	J	K	L
2	6	5	4	3	2							
3												
4	7	8	9	10	11							
5												
6	18	17	16	15	14							
7												
8	19	20	21	22	23							
9												
10	30	29	28	27	26							
11												
12	31	32	33	34	35							
13												

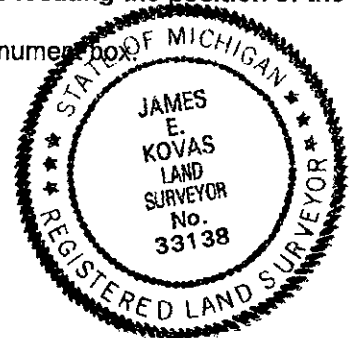

Signed by James E. Kovas

Date 12/22/99

Surveyor's Michigan License No. 33138