

LAND CORNER RECORDATION CERTIFICATE
Filing Requirement of Act 74, Mich. P.A. 1970

1953

LIBER 20945 PAGE 548
\$7.00 MISC RECORDING
\$2.00 REMONUMENTATION
01/04/2000 07:37:46 A.M. RECEIPT# 342
PAID RECORDED - OAKLAND COUNTY
G. WILLIAM CARDELL, CLERK/REGISTER OF DEEDS

For corners in

Oakland Located In: Corner Code #
(county)
Holly Township
1. Public Land Survey T 5N R 7E G-2
T R
T R SURVEY &
T R RE-ESTABLISHMENT
2. Property Controlling S T R
in Section S T R
3. Miscellaneous S T R
Property in Sec. S T R
SECTION

9-23-98 53
REGISTER OF DEEDS STAMP & FILE NUMBER

4. Lot No. _____, Recorded Plat _____

5. Private Claims _____

I, James E. Kovas, in a field survey on September 9, 1998, do hereby certify that under requirements of P.A. 74, Michigan P.A. of 1970, the corner points mentioned in lines 1 and 2 above were in conformance with regulations and rules therefore as required in the current manual of survey instructions of the United States Department of the Interior, Bureau of Land Management or by a decree of a Court of Law and/or that the corner points mentioned in lines 3, 4 and 5 above were in conformance with the rules of the Michigan Board of Land Surveyors or by a Decree of a Court of Law; established, re-established, monumented, re-monumented, recovered, found as expressed below:

A	B	C	D	E	F	G	H	I	J	K	L
2	6	5	4	3	2	1					
3											
4	7	8	9	10	11	12					
5											
6	13	17	16	15	14	13					
7											
8	19	20	21	22	23	24					
9											
10	30	29	28	27	26	25					
11											
12	31	32	33	34	35	36					
13											

NOTE: Not more than 4 corners, all in the same town and range, may be recorded on this certificate.

A. Description of original monument and accessories and/or subsequent restoration:

- G-2
- 1816 - G.L.O., Alex Holmes, D.S., set post
- 1972 - Gary Stonerock #13601 (LCRC Liber 5830, Page 555)
- 1974 - Edward Anderson #11495 (LCRC Liber 6303, Page 740) found and accepted P.K. in center of Holly Road
- 1974 - John Albright #10057 (Survey Liber 6716, Page 746) found P.K. nail
- 1976 - Grant Ward #33445 (Survey Liber 6698, Page 828 and Liber 7213, Page 49) found P.K.
- 1989 - Gil Bonno #32332 (LCRC Liber 11603, pages 672 and Liber 11603, Page 681) found P.K. nail

Distances: G-2 to G-1 = 2961.78' (Wade-Trim, 1998)
G-2 to G-1 = 2970.00' (45 chains, GLO)
G-2 to G-3 = 2618.59' (Wade-Trim, 1998)
G-2 to G-3 = 2619.50' (Newman, 1998)

B. Description of corner evidence found and/or method applied in restoring or reestablishing corner:

G-2 Found 1/2" iron rod in bituminous road surface.


WITNESSES FOUND:

East 1.0' to centerline of road found 1'
N 45 W 90.52' to power pole found 91.48'
S 40 W 67.74' to road sig found 67.9'
S 45 E 36.07' to fence post found 36.04'

C. Description of monument for corner and accessories established to perpetuate locating the position of the corner:

G-2 Removed 1/2" iron and replaced with 5/8" iron and remon cap in monument box.

WIT: S 12 E 70.20' Set nail w/tag #33138 16" Oak
S 28 W 110.57' Set nail w/tag #33138 power pole
N 10 W 59.81' Set nail w/tag #33138 8" pine
N 45 E 41.36' Set nail w/tag #33138 4" Quad

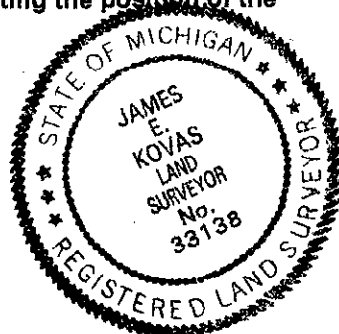

Signed by James E. Kovas Date 12/23/99

Surveyor's Michigan License No. 33138