

LAND CORNER RECORDATION CERTIFICATE
Filing Requirement of Act 74, Mich. P.A. 1970

LIBER 21023 PAGE 532
\$7.00 MISC RECORDING
\$2.00 REMONUMENTATION
01/26/2000 09:06:20 A.M. RECEIPT#
PAID RECORDED - OAKLAND COUNTY
G. WILLIAM CADDELL, CLERK/REGISTER

For corners in

Oakland
(county)

Located In: Corner Code #

Holly Township

- 1. Public Land Survey T 5N R 7E G-3
2. Property Controlling in Section S T R
3. Miscellaneous S T R
Property in Sec. S T R

SURVEY &
REMONUMENTATION
APPROVED ON: 9-23-98 JS
MAR 21 2000

Compliance with
ACT 345, P.A. 1990
Register of Deeds Stamp & File Number

SECTION

4. Lot No. Recorded Plat

5. Private Claims

I, James E. Kovas, in a field survey on September 18, 1998, do hereby certify that under requirements of P.A. 74, Michigan P.A. of 1970, the corner points mentioned in lines 1 and 2 above were in conformance with regulations and rules therefore as required in the current manual of survey instructions of the United States Department of the Interior, Bureau of Land Management or by a decree of a Court of Law and/or that the corner points mentioned in lines 3, 4 and 5 above were in conformance with the rules of the Michigan Board of Land Surveyors or by a Decree of a Court of Law; established, re-established, monumented, re-monumented, recovered, found as expressed below:

NOTE: Not more than 4 corners, all in the same town and range, may be recorded on this certificate.

A. Description of original monument and accessories and/or subsequent restoration:

- G-3
1816 - G.L.O., Alex Holmes, D.S., set post
1974 - Edward Anderson #11495 (LCRC Liber 6303, Page 740) Found railroad spike in center of Holly Road
1977 - Jan Fokens #21567 (Survey Liber 6950, Page 436) no monument described
1977 - John Albright #10057 (Survey Liber 7077, Page 263) found P.K. nail
1989 - Gil Bonno #32332 (LCRC Liber 11603, Page 672) found nail and metal disc


- Distances: G-3 to G-2 = 2618.59' (Wade-Trim, 1998)
G-3 to G-2 = 2619.50' (Newman, 1988)
G-3 to G-2 = 2642.64' (40.04 chains Slater, 1902)
G-3 to H-3 = 2640.43' (Wade-Trim, 1999)
G-3 to H-3 = 2640.66' (Slater, 1902)
G-3 to G-4 = 2647.43' (Wade-Trim, 1998)
G-3 to G-4 = 2647.33' (Newman, 1989)
G-3 to G-4 = 2647.37' (Newman, 1987)
G-3 to F-3 = 2616.10' (Wade-Trim, 1999)
G-3 to F-3 = 2617.22' (Newman, 1989)

B. Description of corner evidence found and/or method applied in restoring or reestablishing corner:

G-3 Found mag nail.

WITNESSES FOUND:

- East 33.0' to iron found 1" pipe 33.07'
West 33.0' to iron found 32.95'
East 33.02' to tag #10057 in telephone pole found 33.03'
West 32.98' to rerod - no cap found 32.95'
East 33.05' to power pole found 33.03'
West 33.00' to 1/2" iron found 32.95'
N 45 W 35.60' to 6" Oak found 35.62'
West 32.95' to 1/2" rerod found 32.95'
East 61.68' to power pole found 61.59'
S 45 E 57.06' to 20" Oak found 56.97'

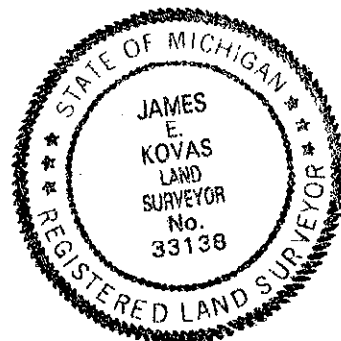

C. Description of monument for corner and accessories established to perpetuate locating the position of the corner:

G-3 Found mag nail in bituminous. Removed and replaced with 1/2" iron in monument box centerline Holly Road.

- WIT: West 32.95' found 1/2" iron
East 33.04' Set P.K. nail w/tag 33138 power pole
S 40 E 57.16' Set P.K. nail w/tag 33138 30" Oak
S 40 W 51.00' Set P.K. nail w/tag 33138 8" twin Maple
N 60 W 36.06' Set P.K. nail w/tag 33138 8" Shag Bark Hickory

Signed by James E. Kovas Date 1/17/00