

LAND CORNER RECORDATION CERTIFICATE
Filing Requirement of Act 74, Mich. P.A. 1970

1956

For corners in

<u>Oakland</u> (county)	Located In:	Corner Code #
	Holly Township	
1. Public Land Survey	T <u>5N</u> R <u>7E</u>	<u>G-6</u>
	T _____ R _____	_____
	T _____ R _____	_____
	T _____ R _____	_____
2. Property Controlling in Section	S _____ T _____	_____
	S _____ T _____	_____
3. Miscellaneous Property in Sec.	S _____ T _____	_____
	S _____ T _____	_____

LIBER 20945 PAGE 551
 \$7.00 MISC RECORDING
 \$2.00 REMONUMENTATION
 01/04/2000 07:37:46 A.M. RECEIPT# 342
 PAID RECORDED - OAKLAND COUNTY
 G. WILLIAM CADDELL, CLERK/REGISTER OF DEEDS

9-23-98 JS
 Register of Deeds Stamp & File Number

SECTION

4. Lot No. _____, Recorded Plat _____
 5. Private Claims _____

A	B	C	D	E	F	G	H	I	J	K
2	6	5	4	3	2					
3										
4	7	8	9	10	11					
5										
6	16	17	18	15	14					
7										
8	19	20	21	22	23					
9										
10	30	29	28	27	26					
11										
12	31	32	33	34	35					
13										

I, James E. Kovas, in a field survey on September 9, 1998, do hereby certify that under requirements of P.A. 74, Michigan P.A. of 1970, the corner points mentioned in lines 1 and 2 above were in conformance with regulations and rules therefore as required in the current manual of survey instructions of the United States Department of the Interior, Bureau of Land Management or by a decree of a Court of Law and/or that the corner points mentioned in lines 3, 4 and 5 above were in conformance with the rules of the Michigan Board of Land Surveyors or by a Decree of a Court of Law; established, re-established, monumented, re-monumented, recovered, found as expressed below:

NOTE: Not more than 4 corners, all in the same town and range, may be recorded on this certificate.

A. Description of original monument and accessories and/or subsequent restoration:

G-6
 1816 - G.L.O., Alex Holmes, D.S., set post

Distances: G-6 to G-5 = 2658.46' (Wade-Trim, 1999)
 G-6 to G-5 = 2655.88' (Newman, 1993)
 G-6 to G-7 = 2643.64' (Wade-Trim, 1999)

B. Description of corner evidence found and/or method applied in restoring or reestablishing corner:

G-6 Found 1/2" iron.

WITNESSES FOUND:


East 1.35'	to railroad tie post	found	1.39'
S 30 W 2.85'	to 10" Cherry	found	2.80'
N 75 W 8.58'	to 8" Cedar	found	8.60'

C. Description of monument for corner and accessories established to perpetuate locating the position of the corner:

G-6 Found 1/2" iron next to 2" iron pipe. Removed and replaced with concrete monument on fence line.

WIT:

S 30 W 2.80'	Set nail w/tag #33138 10" Cherry
N 30 E	Set nail w/tag #33138 36" Oak
N 75 W	Set nail w/tag #33138 8" Cedar
East	Set nail w/tag #33138 railroad tie

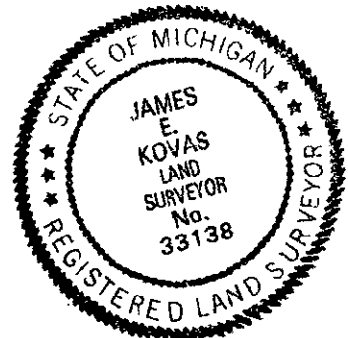

Signed by James Kovas

Date 12/22/99

Surveyor's Michigan License No. 33138