

LAND CORNER RECORDATION CERTIFICATE  
Filing Requirement of Act 74, Mich. P.A. 1970

1957

For corners in

Oakland Located in: Holly Township Corner Code # G-7  
(county)

1. Public Land Survey T 5N R 7E G-7  
T R  
T R  
T R

2. Property Controlling S T R  
in Section S T R

3. Miscellaneous S T R  
Property in Sec. S T R ISAR 21-2000

LIBER 20945 PAGE 552  
\$7.00 MISC RECORDING  
\$2.00 REMONUMENTATION  
01/04/2000 07:37:46 A.M. RECEIPT# 342  
PAID RECORDED - OAKLAND COUNTY  
G. WILLIAM CADDELL, CLERK/REGISTER OF DEE

9-23-98  
Register of Deeds Stamp & File Number

4. Lot No. \_\_\_\_\_, Recorded Plat \_\_\_\_\_ SECTION \_\_\_\_\_

5. Private Claims \_\_\_\_\_

A	B	C	D	E	F	G	H	I	J	K
2	6	5	4	3	2					
3										
4	7	8	9	10	11					
5										
6	18	17	16	15	14					
7										
8	19	20	21	22	23					
9										
10	30	29	28	27	26					
11										
12	31	32	33	34	35					
13										

I, James E. Kovas, in a field survey on February 24, 1998, do hereby certify that under requirements of P.A. 74, Michigan P.A. of 1970, the corner points mentioned in lines 1 and 2 above were in conformance with regulations and rules therefore as required in the current manual of survey instructions of the United States Department of the Interior, Bureau of Land Management or by a decree of a Court of Law and/or that the corner points mentioned in lines 3, 4 and 5 above were in conformance with the rules of the Michigan Board of Land Surveyors or by a Decree of a Court of Law; established, re-established, monumented, re-monumented, recovered, found as expressed below:

NOTE: Not more than 4 corners, all in the same town and range, may be recorded on this certificate.

A. Description of original monument and accessories and/or subsequent restoration:

- G-7 1816 - G.L.O., Alex Holmes, D.S., set post
- 1972 - John Albright #10057 (LCRC Liber 6002, Page 508) found 1/2" rerod

- Distances:
- G-7 to G-6 = 2643.64' (Wade-Trim, 1999)
  - G-7 to G-8 = 2619.53' (Wade-Trim, 1998)
  - G-7 to F-7 = 2649.95' (Wade-Trim, 1999)
  - G-7 to H-7 = 2696.05' (Wade-Trim, 1998)

B. Description of corner evidence found and/or method applied in restoring or reestablishing corner:

G-7 Found 1/2" iron and cap.

WITNESSES FOUND:


- S 20 E 58.0' to telephone pole found 57.87'
- S 10 W 18.5' to stop sign found 17.2' new?
- N 30 W 50.4' to power pole found 50.40'

C. Description of monument for corner and accessories established to perpetuate locating the position of the corner:

G-7 Found 1/2" iron in Elliott Road. Replaced with 5/8" iron cap #33138 in monument box. NOTE: 5' South of North side of Elliott Road.

WIT:

- N 25 W 26.89' Set nail w/tag #33138 8" Apple
- N 44 E 28.28' Set nail w/tag #33138 12" Oak
- N 85 E 35.62' Set nail w/tag #33138 8" Twin Maple
- S 10 E 57.87' Set nail w/tag #33138 in power pole

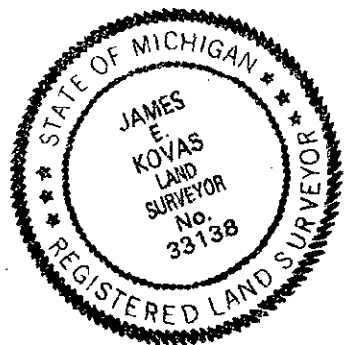

Signed by James E. Kovas Date 12/23/99

Surveyor's Michigan License No. 33138