

LAND CORNER RECORDATION CERTIFICATE
Filing Requirement of Act 74, Mich. P.A. 1970

195B

For corners in

Oakland Located In: Corner Code #
(county)
1. Public Land Survey T 5N R 7E G-8
T R
T R SURVEY &
T R REMONUMENTATION
2. Property Controlling S T R
in Section S T R
3. Miscellaneous S T R
Property in Sec. S T R MAR 21 2000

LIBER 20945 PAGE 553
\$7.00 MISC RECORDING
\$2.00 REMONUMENTATION
01/04/2000 07:37:46 A.M. RECEIPT# 342
PAID RECORDED - OAKLAND COUNTY
G. WILLIAM CADDELL, CLERK/REGISTER OF DEEDS

9-23-98 53
REGISTERED ON
OAKLAND COUNTY REMONUMENTATION
Register of Deeds Stamp & File Number

SECTION

4. Lot No. _____, Recorded Plat _____
5. Private Claims _____

A	B	C	D	E	F	G	H	I	J	K
2	6	5	4	3	2					
3										
4	7	8	9	10	11					
5										
6	18	17	16	15	14					
7										
8	19	20	21	22	23					
9										
10	30	29	28	27	26					
11										
12	31	32	33	34	35					
13										

I, James E. Kovas, in a field survey on November 9, 1999, do hereby certify that under requirements of P.A. 74, Michigan P.A. of 1970, the corner points mentioned in lines 1 and 2 above were in conformance with regulations and rules therefore as required in the current manual of survey instructions of the United States Department of the Interior, Bureau of Land Management or by a decree of a Court of Law and/or that the corner points mentioned in lines 3, 4 and 5 above were in conformance with the rules of the Michigan Board of Land Surveyors or by a Decree of a Court of Law; established, re-established, monumented, re-monumented, recovered, found as expressed below:

NOTE: Not more than 4 corners, all in the same town and range, may be recorded on this certificate.

A. Description of original monument and accessories and/or subsequent restoration:
G-8
1816 - G.L.O., Alex Holmes, D.S., set post
1989 - Lloyd McGinnis #18999 (Survey Liber 11256, Page 769) found 1/2" bar

Distances: G-8 to G-7 = 2619.53' (Wade-Trim, 1998)
G-8 to G-9 = 2643.65' (Wade-Trim, 1998)
G-8 to G-9 = 2643.75' (Wade-Trim (McGinnis) 1989)
G-8 to G-9 = 2653.59' (Newman, 1985)

B. Description of corner evidence found and/or method applied in restoring or reestablishing corner:
G-8 Found 1/2" iron.

WITNESSES FOUND:


S 30 E	47.40'	to 24" Oak	found	47.43'	
East-NE	54.40'	to 8" tree	found	54.17'	
SE	47.45'	to nail in 40" tree	found	47.45'	
NW	57.75'	to nail in 30" tree	found	56.65' center	
North-NW	87.45'	to nail in 24" tree	found	87.45'	

1p
2

C. Description of monument for corner and accessories established to perpetuate locating the position of the corner:
G-8 Found 1/2" iron in centerline Saginaw Road. Removed and replaced with monument box and 5/8" iron with cap #33138.

WIT:

N 23 W 57.40' Set mag nail w/tag #33138 24" Oak
N 78 E 54.83' Set mag nail w/tag #33138 18" Poplar
S 27 E 47.38' Set mag nail w/tag #33138 30" Oak
S 80 W 46.35' Set mag nail w/tag #33138 14" Box Elder

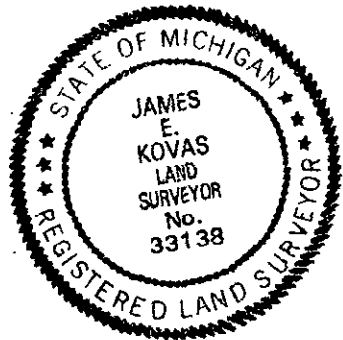

Signed by James E. Kovas Date 12/22/99

Surveyor's Michigan License No. 33138