

LAND CORNER RECORDATION CERTIFICATE  
Filing Requirement of Act 74, Mich. P.A. 1970

1960

For corners in

Oakland Located In: Holly Township Corner Code # G-10  
(county)

1. Public Land Survey T 5N R 7E \_\_\_\_\_  
T \_\_\_\_\_ R \_\_\_\_\_  
T \_\_\_\_\_ R \_\_\_\_\_  
T \_\_\_\_\_ R \_\_\_\_\_

2. Property Controlling S \_\_\_\_\_ T \_\_\_\_\_ R \_\_\_\_\_  
in Section S \_\_\_\_\_ T \_\_\_\_\_ R \_\_\_\_\_

3. Miscellaneous S \_\_\_\_\_ T \_\_\_\_\_ R \_\_\_\_\_  
Property in Sec. S \_\_\_\_\_ T \_\_\_\_\_ R \_\_\_\_\_

LIBER 20945 PAGE 555  
\$7.00 MISC RECORDING  
\$2.00 REMONUMENTATION  
01/04/2000 07:37:46 A.M. RECEIPT# 342  
PAID RECORDED - OAKLAND COUNTY  
G. WILLIAM CADDELL, CLERK/REGISTER OF DEEDS

APPROVED ON: 10-28-98 SS  
OAKLAND COUNTY REGISTER OF DEEDS  
REGISTER OF DEEDS STAMP & FILE NUMBER

4. Lot No. \_\_\_\_\_, Recorded Plat \_\_\_\_\_ SECTION \_\_\_\_\_

5. Private Claims \_\_\_\_\_

	A	B	C	D	E	F	G	H	I	J	K
2	6	5	4	3	2						
3											
4	7	8	9	10	11						
5											
6	18	17	16	15	14						
7											
8	19	20	21	22	23						
9											
10	30	29	28	27	26						
11											
12	31	32	33	34	35						
13											

I, James E. Kovas, in a field survey on 7-16, 98, do hereby certify that under requirements of P.A. 74, Michigan P.A. of 1970, the corner points mentioned in lines 1 and 2 above were in conformance with regulations and rules therefore as required in the current manual of survey instructions of the United States Department of the Interior, Bureau of Land Management or by a decree of a Court of Law and/or that the corner points mentioned in lines 3, 4 and 5 above were in conformance with the rules of the Michigan Board of Land Surveyors or by a Decree of a Court of Law; established, re-established, monumented, re-monumented, recovered, found as expressed below:

NOTE: Not more than 4 corners, all in the same town and range, may be recorded on this certificate.

- A. Description of original monument and accessories and/or subsequent restoration:  
G-10  
1816 - G.L.O., Alex Holmes, D.S., set post  
1949 - Creque Woods Subdivision (Liber 60, Page 7) no monument described  
1972 - John Albright #10067 (Survey, Liber 6404, Page 728) found monument box  
1978 - James Smith #21582 (Survey Liber 7218, Page 475) found monument box  
1979 - James Buckerfield #10868 (Survey Liber 7700, Page 753) found "T" iron in monument box  
1991 - Robert Kohn #26459 (LCRC Liber 11750, Page 895) found iron in monument box

Distances: G-10 to G-9 = 2649.82' (Wade-Trim, 1999)  
G-10 to G-9 = 2649.88' (Newman, 1992)  
G-10 to G-11 = 2634.65' (Wade-Trim, 1999)


B. Description of corner evidence found and/or method applied in restoring or reestablishing corner:  
G-10 Found 1/2" iron in monument box.

WITNESSES FOUND:

S 45 W	53.20'	to nail in corner of sign base	found	53.10'
S 45 E	58.31'	to nail in NE face utility pole	found	58.00'
N 30 E	56.31'	to SE face light pole	found	56.52'

C. Description of monument for corner and accessories established to perpetuate locating the position of the corner:  
G-10 Set Remon cap #33138 on found iron in monument box.

WIT:  
N 40 W 56.94' Set P.K. nail w/tag #33138 utility pole  
N 40 E 63.81' Set P.K. nail w/tag #33138 light pole  
S 35 E 58.22' Set P.K. nail w/tag #33138 utility pole  
S 20 W 127.20' Set P.K. nail w/tag #33138 utility pole

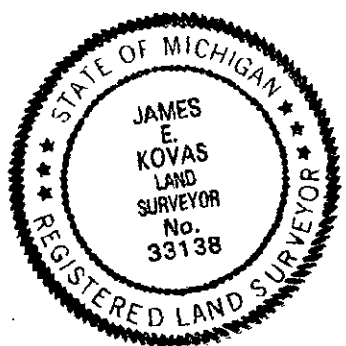

Signed by James E. Kovas Date 12/22/99

Surveyor's Michigan License No. 33138