

LAND CORNER RECORDATION CERTIFICATE
Filing Requirement of Act 74, Mich. P.A. 1970

1963

For corners in

Oakland Located In: Holly Township Corner Code # G-13
(county)

1. Public Land Survey T 5N R 7E _____
T _____ R _____
T _____ R _____
T _____ R _____

2. Property Controlling S _____ T _____ R _____
in Section S _____ T _____ R _____

3. Miscellaneous S _____ T _____ R _____
Property in Sec. S _____ T _____ R _____

LIBER 20945 PAGE 558
\$7.00 MISC RECORDING
\$2.00 REMONUMENTATION
01/04/2000 07:37:46 A.M. RECEIPT# 342
PAID RECORDED - OAKLAND COUNTY
G. WILLIAM CADDELL, CLERK/REGISTER OF DEEDS

RECEIVED ON: 1.5.99 55
OAKLAND COUNTY REGISTER OF DEEDS
REGISTER OF DEEDS STAMP & FILE NUMBER

SECTION

4. Lot No. _____, Recorded Plat _____

5. Private Claims _____

I, James E. Kovas, in a field survey on November 23, 1998, do hereby certify that under requirements of P.A. 74, Michigan P.A. of 1970, the corner points mentioned in lines 1 and 2 above were in conformance with regulations and rules therefore as required in the current manual of survey instructions of the United States Department of the Interior, Bureau of Land Management or by a decree of a Court of Law and/or that the corner points mentioned in lines 3, 4 and 5 above were in conformance with the rules of the Michigan Board of Land Surveyors or by a Decree of a Court of Law; established, re-established, monumented, re-monumented, recovered, found as expressed below:

	A	B	C	D	E	F	G	H	I	J	K	L	M
2	6		5		4		3		2		1		
3													
4	7		8		9		10		11		12		
5													
6	18		17		16		15		14		13		
7													
8	19		20		21		22		23		24		
9													
10	30		29		28		27		26		25		
11													
12	31		32		33		34		35		36		
13													

NOTE: Not more than 4 corners, all in the same town and range, may be recorded on this certificate.

A. Description of original monument and accessories and/or subsequent restoration:
G-13
1816 - G.L.O., Alex Holmes, D.S., set post
1995 - Chris Newman #24607 (Survey Liber 16003, Page 385) found iron in swamp

Distances: G-13 to G-12 = 2645.53' (Wade-Trim, 1998)
G-13 to F-13 = 2651.65' (Wade-Trim, 1998)
G-13 to F-13 = 2651.09' (Newman, 1995)
G-13 to H-13 = 2575.84' (Wade-Trim, 1998)


B. Description of corner evidence found and/or method applied in restoring or reestablishing corner:
G-13 Found "T" iron.

No witnesses to check into except distance check with Newman's surveys.

C. Description of monument for corner and accessories established to perpetuate locating the position of the corner:
G-13 Found "T" iron with cap. Removed and replaced with concrete monument with cap #33138.

WIT:

North 46.00' "T" fence post edge of water West side
East 22.35' 1" iron pipe edge of water North side
South 9.51' "T" fence post edge of water West side
West 46.10' "T" fence post

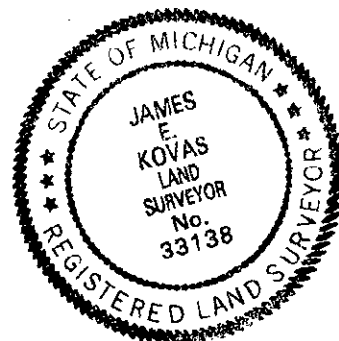

Signed by James E. Kovas Date 12/23/99

Surveyor's Michigan License No. 33138