

LAND CORNER RECORDATION CERTIFICATE
Filing Requirement of Act 74, Mich. P.A. 1970

1964

For corners in

Oakland Located In: Corner Code #
(county)
Holly Township
1. Public Land Survey T 5N R 7E H-1
T R
T R
T R
2. Property Controlling S T R
in Section S T R SURVEY &
3. Miscellaneous S T R RE-ESTABLISHMENT
Property in Sec. S T R MAR 21 2000

LIBER 20945 PAGE 559
\$7.00 MISC RECORDING
\$2.00 REMONUMENTATION
01/04/2000 07:37:46 A.M. RECEIPT# 342
PAID RECORDED - OAKLAND COUNTY
G. WILLIAM CADDELL, CLERK/REGISTER OF DEEDS

Compliance with
ACT 343, P.A. 1990

APPROVED ON: 11-3-99 JK
OAKLAND COUNTY REMONUMENTATION
PEER GROUP COMMITTEE

Register of Deeds Stamp & File Number

4. Lot No. _____, Recorded Plat _____ SECTION _____

5. Private Claims _____

I, James E. Kovas in a field survey on 11-3, 99,
do hereby certify that under requirements of P.A. 74, Michigan P.A. of 1970, the corner points
mentioned in lines 1 and 2 above were in conformance with regulations and rules therefore as
required in the current manual of survey instructions of the United States Department of the Interior,
Bureau of Land Management or by a decree of a Court of Law and/or that the corner points
mentioned in lines 3, 4 and 5 above were in conformance with the rules of the Michigan Board of
Land Surveyors or by a Decree of a Court of Law; established, re-established, monumented,
re-monumented, recovered, found as expressed below:

NOTE: Not more than 4 corners, all in the same town and range, may be recorded on this certificate.

A. Description of original monument and accessories and/or subsequent restoration:

F-1
1816 - G.L.O., Alex Holmes, D.S., not set

Distances: H-1 to G-1 = 2642.51' (Wade-Trim, 1998)

H-1 to I-1 = I-1 is in a Lake

H-1 to J-1 = 5261.60' (Wade-Trim, 1999)

B. Description of corner evidence found and/or method applied in restoring or reestablishing corner:

H-1 Found wood fence corner post with fence to east and to south.


No record surveys of LCRCs or other information was found for this corner for H-13 (Grand Blanc Township)

C. Description of monument for corner and accessories established to perpetuate locating the position of the corner:

H-1 Set 5/8" iron and cap next to tree on Township line on fence line extended North.

WIT: N 65 E 67.59' Set P.K. nail w/tag #33138 18" Oak South face
South 17.17' Set P.K. nail w/tag #33138 24" Oak East face
S 55 W 16.19' Set P.K. nail w/tag #33138 10" Cherry South face
S 85 W 39.74' Set P.K. nail w/tag #33138 8" Hickory North face
East 17.08' Monument Genesee County

	A	B	C	D	E	F	G	H	I	J	K	L	M
2	6	5	4	3	2	1							
3													
4	7	8	9	10	11	12							
5													
6	18	17	16	15	14	13							
7													
8	19	20	21	22	23	24							
9													
10	30	29	28	27	26	25							
11													
12	31	32	33	34	35	36							
13													

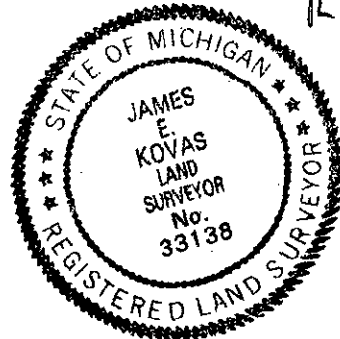

Signed by James E. Kovas

Date 12/23/99

Surveyor's Michigan License No. 33138