

LAND CORNER RECORDATION CERTIFICATE
Filing Requirement of Act 74, Mich. P.A. 1970

24602

LIBER 21023 PAGE 533
\$7.00 MISC RECORDING
\$2.00 REMONUMENTATION
01/26/2000 09:06:21 A.M. RECEIPT# 6359
PAID RECORDED - OAKLAND COUNTY
G. WILLIAM CADDELL, CLERK/REGISTER OF DEEDS

For corners in

Oakland Located In: Corner Code #
(county)
Holly Township
1. Public Land Survey T 5N R 7E H-3
T R
T R
T R
2. Property Controlling S T R
in Section S T R
3. Miscellaneous S T R
Property in Sec. S T R

Compliance with
ACT 345, P.A. 1990
APPROVED ON: 5-12-99 53
OAKLAND COUNTY REMONUMENTATION
PEER GROUP COMMITTEE
Register of Deeds Stamp & File Number

SURVEY &
REMONUMENTATION
MAR 21 2000

4. Lot No. _____, Recorded Plat SECTION
5. Private Claims _____

	A	B	C	D	E	F	G	H	I	J	K	L	M
2	6	5	4	3	2	1							
3													
4	7	8	9	10	11	12							
5													
6	18	17	16	15	14	13							
7													
8	19	20	21	22	23	24							
9													
10	30	29	28	27	26	25							
11													
12	31	32	33	34	35	36							
13													

I, James E. Kovas, in a field survey on November 17, 1999, do hereby certify that under requirements of P.A. 74, Michigan P.A. of 1970, the corner points mentioned in lines 1 and 2 above were in conformance with regulations and rules therefore as required in the current manual of survey instructions of the United States Department of the Interior, Bureau of Land Management or by a decree of a Court of Law and/or that the corner points mentioned in lines 3, 4 and 5 above were in conformance with the rules of the Michigan Board of Land Surveyors or by a Decree of a Court of Law; established, re-established, monumented, re-monumented, recovered, found as expressed below:

NOTE: Not more than 4 corners, all in the same town and range, may be recorded on this certificate.

A. Description of original monument and accessories and/or subsequent restoration:

H-3
1816 - G.L.O., Alex Holmes, D.S., set post

Distances: H-3 to G-3 = 2640.43' (Wade-Trim, 1999)
H-3 to G-3 = 2640.66' (Slater, 1902)

H-3 to I-3 = 2623.17' (Wade-Trim, 1999)
H-3 to I-3 = 2639.34' (39.99 chains GLO)

B. Description of corner evidence found and/or method applied in restoring or reestablishing corner:


H3 Found 1/2" iron in north-south fence line.

We recommend that the corner be placed on line between G-3 and I-3. This agrees well with the north-south fence. There is no possession evidence in the east-west direction.

C. Description of monument for corner and accessories established to perpetuate locating the position of the corner:

H-3 Found 1/2" iron in fence line. Removed and replaced with concrete monument with cap #33138 700'+/- South of Belford.

WIT: North 43.41' Metal fence post
S 65 E 60.65' Set P.K. nail w/tag #33138
S 15 W 13.67' Set P.K. nail w/tag #33138

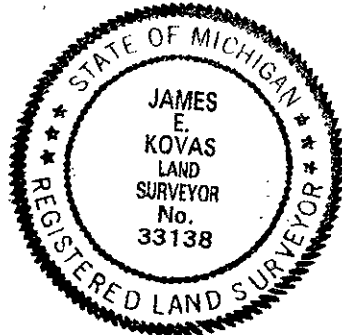

1P
R

Signed by James E. Kovas

Date 1/17/00

Surveyor's Michigan License No. 33138