

LAND CORNER RECORDATION CERTIFICATE
Filing Requirement of Act 74, Mich. P.A. 1970

1965

For corners in

Oakland Located In: Corner Code #
(county)

Holly Township

1. Public Land Survey T 5N R 7E H-5
T R
T R
T R

2. Property Controlling S T R
in Section S T R

3. Miscellaneous S T R
Property in Sec. S T R MAR 21 2000

LIBER 20945 PAGE 560
\$7.00 MISC RECORDING
\$2.00 REMONUMENTATION
01/04/2000 07:37:46 A.M. RECEIPT# 342
PAID RECORDED - OAKLAND COUNTY
G. WILLIAM CADDELL, CLERK/REGISTER OF DEEDS

APPROVED ON: 9-22-99 JR
OAKLAND COUNTY REMONUMENTATION
TASK GROUP COMMITTEE
Register of Deeds Stamp & File Number

SECTION

4. Lot No. _____, Recorded Plat _____

5. Private Claims _____

I, James E. Kovas, in a field survey on November 24, 1999, do hereby certify that under requirements of P.A. 74, Michigan P.A. of 1970, the corner points mentioned in lines 1 and 2 above were in conformance with regulations and rules therefore as required in the current manual of survey instructions of the United States Department of the Interior, Bureau of Land Management or by a decree of a Court of Law and/or that the corner points mentioned in lines 3, 4 and 5 above were in conformance with the rules of the Michigan Board of Land Surveyors or by a Decree of a Court of Law; established, re-established, monumented, re-monumented, recovered, found as expressed below:

NOTE: Not more than 4 corners, all in the same town and range, may be recorded on this certificate.

A. Description of original monument and accessories and/or subsequent restoration:

H-5
1816 - G.L.O., Alex Holmes, D.S., set post

Distances: H-5 to G-5 = 2596.59' (Wade-Trim, 1999)
H-5 to G-5 = 2602.38' (GLO-39.43 chains)

H-5 to I-5 = 2596.59' (Wade-Trim, 1999)
H-5 to I-5 = 2602.38' (GLO-39.43 chains)

B. Description of corner evidence found and/or method applied in restoring or reestablishing corner:

H-5 No monument found.



This corner falls in the middle of a plowed field. The farmer who farms the field said that he has never seen any section corner or post in the field for as long as he has been farming. There is no survey or other evidence in the record of this corner.

We propose to set this corner half way and on line between G-5 and I-5. The split agrees very well with the GLO distance.

C. Description of monument for corner and accessories established to perpetuate locating the position of the corner:

H-5 Set concrete monument in field with cap #33138.

WIT: N 91 W 93.64' Set P.K. nail w/tag #33138 30" Shag Hickory
N 47 W 285.353' Set P.K. nail w/tag #33138 14" Elm
East 375'+/- To fence line North-South

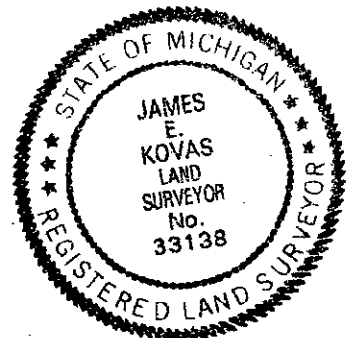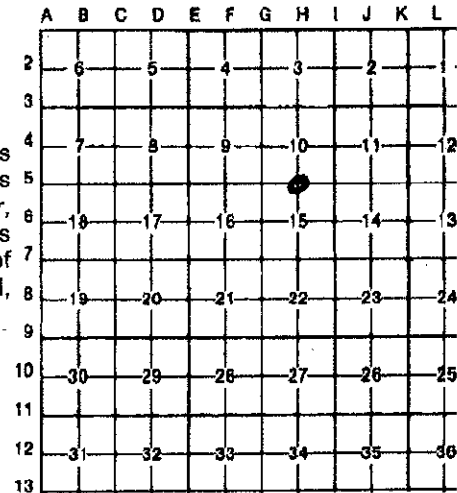

Signed by James E. Kovas Date 12/22/99

Surveyor's Michigan License No. 33138