

LAND CORNER RECORDATION CERTIFICATE  
Filing Requirement of Act 74, Mich. P.A. 1970

1967

For corners in

LIBER 20945 PAGE 562  
\$7.00 MISC RECORDING  
\$2.00 REMONUMENTATION  
01/04/2000 07:37:46 A.M. RECEIPT# 342  
PAID RECORDED - OAKLAND COUNTY  
G. WILLIAM CADDELL, CLERK/REGISTER OF DEEDS

Oakland Located In: Corner Code #  
(county)

1. Public Land Survey T 5N R 7E H-9  
T R  
T R SURVEY &  
T R RE-MONUMENTATION  
2. Property Controlling S T R  
in Section S T R  
3. Miscellaneous S T R  
Property in Sec. S T R  
SECTION

Complies with  
ACT 74, P.A. 1970

APPROVED ON: 1-5-99 SS  
OAKLAND COUNTY REMONUMENTATION  
REGISTER OF DEEDS STAMP & FILE NUMBER

4. Lot No. \_\_\_\_\_, Recorded Plat \_\_\_\_\_

5. Private Claims \_\_\_\_\_

I, James E. Kovas, in a field survey on November 25, 1998, do hereby certify that under requirements of P.A. 74, Michigan P.A. of 1970, the corner points mentioned in lines 1 and 2 above were in conformance with regulations and rules therefore as required in the current manual of survey instructions of the United States Department of the Interior, Bureau of Land Management or by a decree of a Court of Law and/or that the corner points mentioned in lines 3, 4 and 5 above were in conformance with the rules of the Michigan Board of Land Surveyors or by a Decree of a Court of Law; established, re-established, monumented, re-monumented, recovered, found as expressed below:

NOTE: Not more than 4 corners, all in the same town and range, may be recorded on this certificate.

A. Description of original monument and accessories and/or subsequent restoration:

H-9  
1816 - G.L.O., Alex Holmes, D.S., set post

Distances: H-9 to G-9 = 2607.06' (Wade-Trim, 1998)

H-9 to I-9 = 2609.49' (Wade-Trim, 1998)

B. Description of corner evidence found and/or method applied in restoring or reestablishing corner:

H-9 Found 1/2" iron in fence line.

Witnesses found with no record to compare with:

WITNESSES FOUND:


S 35 W 31.45' to nail in 6" Twin Maple

C. Description of monument for corner and accessories established to perpetuate locating the position of the corner:

H-9 Found 1/2" iron on fence line. Removed and replaced with concrete monument.

WIT: S 40 E 28.53' Set nail w/tag #33138  
S 35 W 31.42' Set nail w/tag #33138  
N 85 W 34.30' Set nail w/tag #33138

	A	B	C	D	E	F	G	H	I	J	K	L
2	6	5	4	3	2							
3												
4	7	8	9	10	11							
5												
6	18	17	16	15	14							
7												
8	19	20	21	22	23							
9												
10	30	29	28	27	26							
11												
12	31	32	33	34	35							
13												

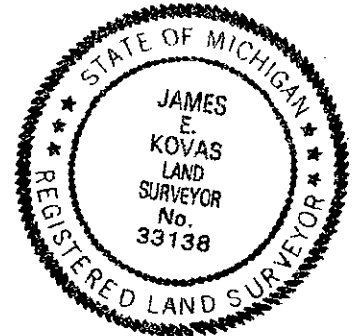

Signed by James E. Kovas Date 12/22/99

Surveyor's Michigan License No. 33138