

LAND CORNER RECORDATION CERTIFICATE
Filing Requirement of Act 74, Mich. P.A. 1970

1968

For corners in

Oakland Located In: Holly Township Corner Code #
(county)
1. Public Land Survey T 5N R 7E H-13
T R
T R
T R
2. Property Controlling S T R RE...
in Section S T R
3. Miscellaneous S T R MAR 21 2000
Property in Sec. S T R

LIBER 20945 PAGE 563
\$7.00 MISC RECORDING
\$2.00 REMONUMENTATION
01/04/2000 07:37:46 A.M. RECEIPT# 342
PAID RECORDED - OAKLAND COUNTY
G. WILLIAM CADDELL, CLERK/REGISTER OF DEED

RECEIVED ON: 1-5-99 JS
OAKLAND COUNTY REMONUMENTATION
DEPT. COUNTY CLERK'S OFFICE
Register of Deeds Stamp & File Number

SECTION

4. Lot No. _____, Recorded Plat _____
5. Private Claims _____

	A	B	C	D	E	F	G	H	I	J	K	L
2	6	5	4	3	2	1						
3												
4	7	8	9	10	11	12						
5												
6	18	17	16	15	14	13						
7												
8	19	20	21	22	23	24						
9												
10	30	29	28	27	26	25						
11												
12	31	32	33	34	35	36						
13												

I, James E. Kovas, in a field survey on November 24, 1998, do hereby certify that under requirements of P.A. 74, Michigan P.A. of 1970, the corner points mentioned in lines 1 and 2 above were in conformance with regulations and rules therefore as required in the current manual of survey instructions of the United States Department of the Interior, Bureau of Land Management or by a decree of a Court of Law and/or that the corner points mentioned in lines 3, 4 and 5 above were in conformance with the rules of the Michigan Board of Land Surveyors or by a Decree of a Court of Law; established, re-established, monumented, re-monumented, recovered, found as expressed below:

NOTE: Not more than 4 corners, all in the same town and range, may be recorded on this certificate.

A. Description of original monument and accessories and/or subsequent restoration:

H-13
1816 - G.L.O., Alex Holmes, D.S., set post

Distances: H-13 to G-13 = 2575.84' (Wade-Trim, 1998)

H-13 to G-13 = 2661.36' (Wade-Trim, 1998)

B. Description of corner evidence found and/or method applied in restoring or reestablishing corner:


H-13 Found 1/2" rerod in center of paved road with remon cap #24598.

No record surveys of LCRCs were found for this corner.

C. Description of monument for corner and accessories established to perpetuate locating the position of the corner:

H-13 Found 1/2" iron in centerline road. Removed and replaced with monument box 5/8" iron with cap #33138.

WIT: N 72 W 19.49' Set nail w/tag #33138 6" Locust
S 53 W 31.57' Set nail w/tag #33138 6" Locust
South 103.19' Set nail w/tag #33138 8" Locust
East 44.43' Old wood fence post

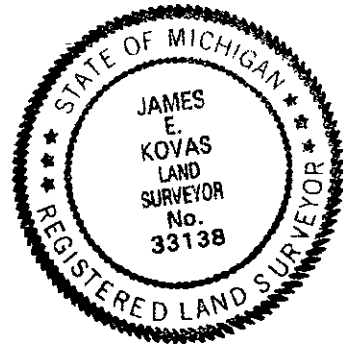

Signed by James E. Kovas

Date 12/22/99

Surveyor's Michigan License No. 33138