

LAND CORNER RECORDATION CERTIFICATE
Filing Requirement of Act 74, Mich. P.A. 1970

1969

For corners in

Oakland Located In: Holly Township Corner Code # 1-2
(county)

1. Public Land Survey T 5N R 7E _____
T _____ R _____
T _____ R _____
T _____ R _____

2. Property Controlling S _____ T _____ R _____
in Section S _____ T _____ R _____

3. Miscellaneous S _____ T _____ R _____
Property in Sec. S _____ T _____ R _____

LIBER 20945 PAGE 564
\$7.00 MISC RECORDING
\$2.00 REMONUMENTATION
01/04/2000 07:37:46 A.M. RECEIPT# 342
PAID RECORDED - OAKLAND COUNTY
G. WILLIAM CADDELL, CLERK/REGISTER OF DEEDS

APPROVED ON: 9-23-96 SS
OAKLAND COUNTY REGISTER OF DEEDS
Register of Deeds Stamp & File Number

SECTION

4. Lot No. _____, Recorded Plat _____

5. Private Claims _____

| A | B | C | D | E | F | G | H | I | J | K | L | M |
|----|----|----|----|----|----|----|---|---|---|---|---|---|
| 2 | 6 | 5 | 4 | 3 | 2 | 1 | | | | | | |
| 3 | | | | | | | | | | | | |
| 4 | 7 | 8 | 9 | 10 | 11 | 12 | | | | | | |
| 5 | | | | | | | | | | | | |
| 6 | 18 | 17 | 16 | 15 | 14 | 13 | | | | | | |
| 7 | | | | | | | | | | | | |
| 8 | 19 | 20 | 21 | 22 | 23 | 24 | | | | | | |
| 9 | | | | | | | | | | | | |
| 10 | 30 | 29 | 28 | 27 | 26 | 25 | | | | | | |
| 11 | | | | | | | | | | | | |
| 12 | 31 | 32 | 33 | 34 | 35 | 36 | | | | | | |
| 13 | | | | | | | | | | | | |

I, James E. Kovas, in a field survey on July 17, 1998, do hereby certify that under requirements of P.A. 74, Michigan P.A. of 1970, the corner points mentioned in lines 1 and 2 above were in conformance with regulations and rules therefore as required in the current manual of survey instructions of the United States Department of the Interior, Bureau of Land Management or by a decree of a Court of Law and/or that the corner points mentioned in lines 3, 4 and 5 above were in conformance with the rules of the Michigan Board of Land Surveyors or by a Decree of a Court of Law; established, re-established, monumented, re-monumented, recovered, found as expressed below:

NOTE: Not more than 4 corners, all in the same town and range, may be recorded on this certificate.

A. Description of original monument and accessories and/or subsequent restoration:

- I-2
- 1816 - G.L.O., Alex Holmes, D.S., set post
- 1962 - Oakland County Road Commission - no monument described
- 1972 - Gary Stonerock #13601 (LCRC Liber 5830, Page 555) found railroad spike
- 1976 - Grant Ward #22445 (Survey Liber 6698, Page 828 and Liber 7213, Page 49) set Iron rod and cap from mwitnesses in Liber 5830, Page 555 (see above)
- 1980 - Grant Ward #22445 (Survey Liber 7947, Page 877) set iron rod and cap from witnesses in Liber 5830, Page 555 (see above)

Distances: I-2 to I-1 = I-1 is in a Lake
I-2 to I-3 = 2634.20' (Wade-Trim, 1998)
I-2 to I-3 = 2634.24' (Gould, 1984)

B. Description of corner evidence found and/or method applied in restoring or reestablishing corner:

I-2 Found 1/2" iron rod.

WITNESSES FOUND:


| | | | | |
|--------|--------|--------------------------------|-------|--------|
| SW | 28.07' | to P.K. in 8" Walnut | found | 28.12' |
| SE | 26.07' | to P.K. in 14" Oak (same tree) | found | 25.13' |
| S 5 E | 24.90' | to P.K. in 14" Oak | found | 25.13' |
| S 60 W | 28.07' | to P.K. in Triple 8" Walnut | found | 28.12' |

IP
R

C. Description of monument for corner and accessories established to perpetuate locating the position of the corner:

I-2 Found 1/2" iron. Set remon cap #33138.

- WIT: North 30.58' Set P.K./tag #33138 East face 24" Oak
- N 43 E 34.12' Set P.K./tag #33138 SE face 6" Elm
- S 18 E 25.97' Set P.K./tag #33138 East face 28" Oak
- S 63 W 29.54' Set P.K./tag #33138 North face 8" Walnut

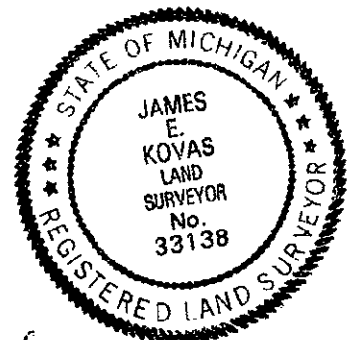

Signed by James E. Kovas Date 12/22/99

Surveyor's Michigan License No. 33138