

LAND CORNER RECORDATION CERTIFICATE
Filing Requirement of Act 74, Mich. P.A. 1970

1970

LIBER 20945 PAGE 565
\$7.00 MISC RECORDING
\$2.00 REMONUMENTATION
01/04/2000 07:37:46 A.M. RECEIPT# 342
PAID RECORDED - OAKLAND COUNTY
G. WILLIAM CADDELL, CLERK/REGISTER OF DEEDS

For corners in

Oakland Located In: Corner Code #
(county)
1. Public Land Survey Holly Township
T 5N R 7E I-3
T R SURVEY &
T R RE-ESTABLISHMENT
T R
2. Property Controlling S T R
in Section S T R
3. Miscellaneous S T R
Property in Sec. S T R
SECTION

APPROVED ON: 9-23-98 JS
OAKLAND COUNTY RE-MONUMENTATION
REGISTER OF DEEDS STAMP & FILE NUMBER

4. Lot No. _____, Recorded Plat _____
5. Private Claims _____

I, James E. Kovas in a field survey on July 28, 1998, do hereby certify that under requirements of P.A. 74, Michigan P.A. of 1970, the corner points mentioned in lines 1 and 2 above were in conformance with regulations and rules therefore as required in the current manual of survey instructions of the United States Department of the Interior, Bureau of Land Management or by a decree of a Court of Law and/or that the corner points mentioned in lines 3, 4 and 5 above were in conformance with the rules of the Michigan Board of Land Surveyors or by a Decree of a Court of Law; established, re-established, monumented, re-monumented, recovered, found as expressed below:

	A	B	C	D	E	F	G	H	I	J	K	L
2	5	5	4	3	2							
3												
4	7	8	9	10	11							
5												
6	18	17	16	15	14							
7												
8	19	20	21	22	23							
9												
10	30	29	28	27	26							
11												
12	31	32	33	34	35							
13												

NOTE: Not more than 4 corners, all in the same town and range, may be recorded on this certificate.

A. Description of original monument and accessories and/or subsequent restoration:

I-3
1816 - G.L.O., Alex Holmes, D.S., set post
1978 - John Albright #10057 (LCRC Liber 7455, Page 863) found 1/2" rerod


Distances: I-3 to I-2 = 2634.20' (Wade-Trim, 1998)
I-3 to I-2 = 2634.24' (Gould, 1984)
I-3 to I-4 = 2638.83' (Wade-Trim, 1998)
I-3 to I-4 = 2638.79' (Albright, 1979)
I-3 to H-3 = 2622.81' (Wade-Trim, 1998)
I-3 to J-3 = 2649.29' (Wade-Trim, 1998)

B. Description of corner evidence found and/or method applied in restoring or reestablishing corner:

I-3 Found 1/2" iron rod and Ward cap #22445.

WITNESSES FOUND:

N 60 E	51.67'	to 12" Beech	found	51.72'
S 60 E	44.38'	to 18" Hickory	found	44.42'
N 30 W	17.35'	to 48" Oak	found	17.43'
N 60 E	51.74'	to found nail 12" Beech	found	51.72'
S 60 E	44.44'	to found nail/tag in 18" Hickory	found	44.42'
N 30 W	17.28'	to found nail and tag	found	17.43'

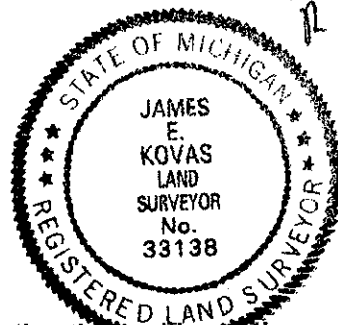

C. Description of monument for corner and accessories established to perpetuate locating the position of the corner:

I-3 Found 1/2" iron and cap (Ward #22445). Set remon cap #33138.

WIT: N 32 E 64.14' Set P.K./tag #33138 SE face power pole
S 72 E 55.40' Set P.K./tag #33138 SW face 14" Hickory
S 14 W 86.70' Set P.K./tag #33138 East face 4" Hickory
N 27 W 86.35' Set P.K./tag #33138 South face 14" Ash

Signed by James E. Kovas Date 12/22/99