

LAND CORNER RECORDATION CERTIFICATE  
Filing Requirement of Act 74, Mich. P.A. 1970

1971

For corners in

LIBER 20945 PAGE 566  
\$7.00 MISC RECORDING  
\$2.00 REMONUMENTATION  
01/04/2000 07:37:46 A.M. RECEIPT# 342  
PAID RECORDED - OAKLAND COUNTY  
G. WILLIAM CADDELL, CLERK/REGISTER OF DEEDS

Oakland Located In: Corner Code #  
(county)  
1. Public Land Survey Holly Township  
T 5N R 7E I-4  
T R  
T R SURVEY &  
T R REMONUMENTATION  
2. Property Controlling S T R  
in Section S T R  
3. Miscellaneous S T R  
Property in Sec. S T R

RECORDED ON: 1-5-99 55  
OAKLAND COUNTY REMONUMENTATION  
Register of Deeds Stamp & File Number

SECTION

4. Lot No. \_\_\_\_\_, Recorded Plat \_\_\_\_\_  
5. Private Claims \_\_\_\_\_

	A	B	C	D	E	F	G	H	I	J	K	L
2	6	5	4	3	2							
3												
4	7	8	9	10	11							
5												
6	18	17	16	15	14							
7												
8	19	20	21	22	23							
9												
10	30	29	28	27	26							
11												
12	31	32	33	34	35							
13												

I, James E. Kovas in a field survey on July 28, 1998, do hereby certify that under requirements of P.A. 74, Michigan P.A. of 1970, the corner points mentioned in lines 1 and 2 above were in conformance with regulations and rules therefore as required in the current manual of survey instructions of the United States Department of the Interior, Bureau of Land Management or by a decree of a Court of Law and/or that the corner points mentioned in lines 3, 4 and 5 above were in conformance with the rules of the Michigan Board of Land Surveyors or by a Decree of a Court of Law; established, re-established, monumented, re-monumented, recovered, found as expressed below:

NOTE: Not more than 4 corners, all in the same town and range, may be recorded on this certificate.

A. Description of original monument and accessories and/or subsequent restoration:

I-4  
1816 - G.L.O., Alex Holmes, D.S., set post  
1978 - John Albright #10057 (LCRC Liber 7455, Page 863) found 3/4" rerod

Distances: I-4 to I-3 = 2638.83' (Wade-Trim, 1998)  
I-4 to I-3 = 2638.79' (Albright, 1979)  
I-4 to I-3 = 2638.79' (Newman, 1990)  
I-4 to I-3 = 2638.79' (Tax map)  
  
I-4 to I-5 = 2635.48' (Wade-Trim, 1999)  
I-4 to I-5 = 2638.79' (Newman, 1990)

B. Description of corner evidence found and/or method applied in restoring or reestablishing corner:

I-4 Found 3/4" rerod

WITNESSES FOUND:


N 80 E 30.90' to power pole found 30.84'  
N 45 W 31.07' to telephone pole found 31.15'  
N 20 W 56.47' to 27" Oak found 56.38' center

lp  
R

C. Description of monument for corner and accessories established to perpetuate locating the position of the corner:

I-4 Found 3/4" iron rod. Removed and replaced with 5/8" iron cap #33138.

WIT: N 40 W 31.05' Set P.K./tag #33138 telephone pole South face  
N 45 E 33.31' Set P.K./tag #33138 6" Ash West face  
N 15 W 56.38' Set P.K./tag #33138 28" Oak East face  
N 80 E 31.18' Set P.K./tag #33138 power pole

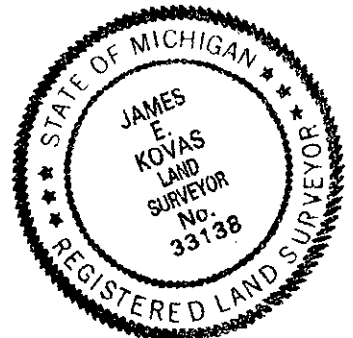

Signed by James E. Kovas Date 12/23/99