

LAND CORNER RECORDATION CERTIFICATE
Filing Requirement of Act 74, Mich. P.A. 1970

1972

LIBER 20945 PAGE 567
\$7.00 MISC RECORDING
\$2.00 REMONUMENTATION
01/04/2000 07:37:46 A.M. RECEIPT# 342
PAID RECORDED - OAKLAND COUNTY
G. WILLIAM CADDELL, CLERK/REGISTER OF DEEDS

For corners in

Oakland Located In: Holly Township Corner Code # _____
(county)

1. Public Land Survey T 5N R 7E _____ I-5
T _____ R _____
T _____ R _____

2. Property Controlling S _____ T _____ R _____
in Section S _____ T _____ R _____


3. Miscellaneous S _____ T _____ R _____
Property in Sec. S _____ T _____ R _____

APPROVED ON: 9-22-99 JLL
OAKLAND COUNTY REMONUMENTATION
Register of Deeds Stamp & File Number

SECTION

4. Lot No. _____ Recorded Plat _____

5. Private Claims _____

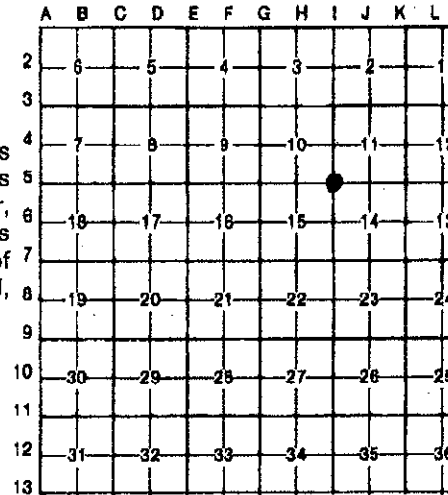

I, James E. Kovas, in a field survey on February 23, 1999, do hereby certify that under requirements of P.A. 74, Michigan P.A. of 1970, the corner points mentioned in lines 1 and 2 above were in conformance with regulations and rules therefore as required in the current manual of survey instructions of the United States Department of the Interior, Bureau of Land Management or by a decree of a Court of Law and/or that the corner points mentioned in lines 3, 4 and 5 above were in conformance with the rules of the Michigan Board of Land Surveyors or by a Decree of a Court of Law; established, re-established, monumented, re-monumented, recovered, found as expressed below:

NOTE: Not more than 4 corners, all in the same town and range, may be recorded on this certificate.

A. Description of original monument and accessories and/or subsequent restoration:

I-5
1816 - G.L.O., Alex Holmes, D.S., set post
1990 - Chris Newman #24607 (LCRC Liber 11604, Page 653 and unrecorded survey) set 6' long, 1/2" rerod in lake

- Distances: I-5 to I-4 = 2635.48' (Wade-Trim, 1999)
I-5 to I-4 = 2638.79' (Newman, 1990)
- I-5 to I-6 = 2635.57' (Wade-Trim, 1999)
I-5 to I-6 = 2633.16' (Newman, 1990)
- I-5 to J-5 = J-5 is in a lake
- I-5 to H-5 = 2596.59' (Wade-Trim, 1999)
I-5 to H-5 = 2602.38' (GLO)

B. Description of corner evidence found and/or method applied in restoring or reestablishing corner:

I-5 Found 1/2" rerod in Lake. Found 1/2" rerod offset on shore 50' +/- (44.69' M) to west

See letter dated April 23, 1999 from Chris Newman.


WITNESSES FOUND:

S 89-57-20 W 50.00' Set 1/2" rerod found 44.69'

C. Description of monument for corner and accessories established to perpetuate locating the position of the corner:

I-5 Set 5/8" iron with remon cap #33138 at double-proportioned location per Peer review.

- WIT: N 55 W 42.25' Set P.K. nail w/tag #33138 10" Oak Twin
S 85 W 29.27' Set P.K. nail w/tag #33138 4" Elm
S 20 W 32.48' Set P.K. nail w/tag #33138 12" Oak

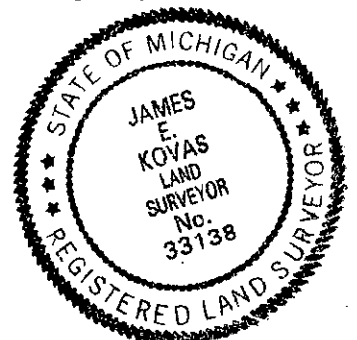

Signed by James Kovas Date 12/23/99

Surveyor's Michigan License No. 33138