

LAND CORNER RECORDATION CERTIFICATE
Filing Requirement of Act 74, Mich. P.A. 1970

1974

For corners in

Oakland Located In: Corner Code #
(county)

Holly Township
1. Public Land Survey T 5N R 7E I-7
T R
T R
T R
2. Property Controlling S T R
in Section S T R
3. Miscellaneous S T R
Property in Sec. S T R

LIBER 20945 PAGE 569
\$7.00 MISC RECORDING
\$2.00 REMONUMENTATION
01/04/2000 07:37:46 A.M. RECEIPT# 342
PAID RECORDED - OAKLAND COUNTY
G. WILLIAM CADDELL, CLERK/REGISTER OF DEEDS

COPIED ON: 9-23-98 JS
REGISTER OF DEEDS STAMP & FILE NUMBER

SECTION

4. Lot No. _____, Recorded Plat _____
5. Private Claims _____

A	B	C	D	E	F	G	H	I	J	K
2	6	5	4	3	2					
3										
4	7	8	9	10	11					
5										
6	16	17	18	19	14					
7										
8	19	20	21	22	23					
9										
10	30	29	28	27	26					
11										
12	31	32	33	34	35					
13										

I, James E. Kovas, in a field survey on July 17, 1998, do hereby certify that under requirements of P.A. 74, Michigan P.A. of 1970, the corner points mentioned in lines 1 and 2 above were in conformance with regulations and rules therefore as required in the current manual of survey instructions of the United States Department of the Interior, Bureau of Land Management or by a decree of a Court of Law and/or that the corner points mentioned in lines 3, 4 and 5 above were in conformance with the rules of the Michigan Board of Land Surveyors or by a Decree of a Court of Law; established, re-established, monumented, re-monumented, recovered, found as expressed below:

NOTE: Not more than 4 corners, all in the same town and range, may be recorded on this certificate.

- A. Description of original monument and accessories and/or subsequent restoration:
I-7
1816 - G.L.O., Alex Holmes, D.S., set post
1962 - Oakland County Road Commission
1975 - John Albright #10057 (LCRC Liber 6813, Page 489) found 5/8" rod
1988 - Chris Newman #24607 (Survey Liber 10519, Page 641) no monument described

- Distances: I-7 to H-7 = 2544.48' (Wade-Trim, 1998)
I-7 to I-6 = 2647.94' (Wade-Trim, 1998)
I-7 to I-6 = 2648.77' (Newman, 1988)
I-7 to I-6 = 2648.77' (Albright, 1973)
I-7 to J-7 = 2677.19' (Wade-Trim, 1998)
I-7 to J-7 = 2641.24' (Wade-Trim, 1999)
I-7 to I-8 = 2641.28' (Newman, 1988)

B. Description of corner evidence found and/or method applied in restoring or reestablishing corner:
I-7 Found 5/8" iron.


- | | | | | |
|--------|--------|----------------------------------|-------|--------------|
| N 80 W | 24.50' | to tag in 30" Oak | found | 24.52' |
| N 76 W | 24.42' | to nail/tag in East face 36" Oak | found | 24.52' |
| S 45 E | 31.16' | to nail in 8" Poplar | found | 28.9' center |
| East | 14.33' | to East end of North culvert | found | 14.33' |

lp
2

C. Description of monument for corner and accessories established to perpetuate locating the position of the corner:

I-7 Found 5/8" iron. Set remon cap #33138.

- WIT: N 70 W 25.37' Set P.K./tag #33138 NE face 26" Oak
S 45 E 28.89' Set P.K./tag #33138 West face 12" Poplar
N 18 E 70.93' Set P.K./tag #33138 West face 14" Willow
East 14.20' East edge culvert chisled "X"

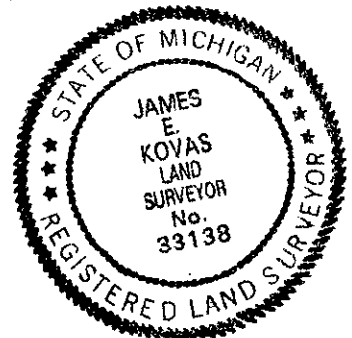

Signed by James E. Kovas Date 12/22/99