

LAND CORNER RECORDATION CERTIFICATE
Filing Requirement of Act 74, Mich. P.A. 1970

1976

For corners in

LIBER 20945 PAGE 571
\$7.00 MISC RECORDING
\$2.00 REMONUMENTATION
01/04/2000 07:37:46 A.M. RECEIPT# 342
PAID RECORDED - OAKLAND COUNTY
G. WILLIAM CADDELL, CLERK/REGISTER OF DEED

Oakland Located In: Corner Code #
(county)
1. Public Land Survey Holly Township
T 5N R 7E I-9
T ___ R ___ SURVEY &
T ___ R ___ REFERENCE STATION
T ___ R ___
2. Property Controlling S ___ T ___ R ___
in Section S ___ T ___ R ___ MAR 21 2000
3. Miscellaneous S ___ T ___ R ___
Property in Sec. S ___ T ___ R ___ SECTION

Approved on: 1-5-99 ss
OAKLAND COUNTY REMONUMENTATION
FILE GROUP 01-11-11-11

Register of Deeds Stamp & File Number

4. Lot No. _____, Recorded Plat _____

5. Private Claims _____

I, James E. Kovas, in a field survey on October 11, 1998, do hereby certify that under requirements of P.A. 74, Michigan P.A. of 1970, the corner points mentioned in lines 1 and 2 above were in conformance with regulations and rules therefore as required in the current manual of survey instructions of the United States Department of the Interior, Bureau of Land Management or by a decree of a Court of Law and/or that the corner points mentioned in lines 3, 4 and 5 above were in conformance with the rules of the Michigan Board of Land Surveyors or by a Decree of a Court of Law; established, re-established, monumented, re-monumented, recovered, found as expressed below:

A	B	C	D	E	F	G	H	I	J	K
2	6	5	4	3	2					
3										
4	7	8	9	10	11					
5										
6	16	17	18	15	14					
7										
8	19	20	21	22	23					
9										
10	30	29	28	27	26					
11										
12	31	32	33	34	35					
13										

NOTE: Not more than 4 corners, all in the same town and range, may be recorded on this certificate.

A. Description of original monument and accessories and/or subsequent restoration:

- I-9
- 1816 - G.L.O., Alex Holmes, D.S., set post
- 1958 - Oakland County Road Commission (section ties) found 5/8" iron
- 1959 - Ni-Dell Subdivision No. 2 (Liber 100, Page 24) no monument described
- 1973 - D. Scott #12029 (LCRC Liber 6073, Page 763) found cast iron monument 1.0' South of Grange Hall Road with 3/4" iron
- 1995 - Grant Ward #22445 (LCRC Liber 15519, Page 024) found 1/2" iron rod in monument box

- Distances:
- I-9 to I-10 = 2643.10' (Wade-Trim, 1998)
 - I-9 to I-10 = 2643.57' (Newman, 1989)
 - I-9 to I-10 = 2643.57' (Albright, 1979)
 - I-9 to I-8 = 2630.67' (Wade-Trim, 1998)
 - I-9 to H-9 = 2609.49' (Wade-Trim, 1999)
 - I-9 to J-9 = 2654.98' (Wade-Trim, 1998)

B. Description of corner evidence found and/or method applied in restoring or reestablishing corner:

I-9 Found 1/2" iron in monument box.


WITNESSES FOUND:

NE 66.08'	to 12" Appled	found	64.90'	lp R
NW 47.44'	to power pole	found	47.98'	
N 9 E 47.40'	to telephone Pole	found	47.98'	
N 35 E 65.90'	to 15" Apple	found	64.90'	
N 15 W 47.30'	to telephone pole	found	47.98'	
N 50 E 64.83'	to set P.K. tag #22445 in SE face 18" Apple	found	64.90'	
S 35 E 282.62'	to set P.K. tag #22445 in SE face power pole	found	282.72'	
N 9 W 47.40'	to found P.K. in East face telephone pole	found	47.98'	

C. Description of monument for corner and accessories established to perpetuate locating the position of the corner:

I-9 Found 1/2" iron monument box centerline road Grange Hall Road. Placed cap #333138.

- WIT:
- N 56 E 64.91' Set P.K. nail w/tag #33138 12" Apple West face
 - N 17 W 48.05' Set P.K. nail w/tag #33138 power pole cut 4' tall West face
 - S 22 E 30.70' Sign post (50 mph speed limit)
 - N 34 W 41.85' Sign post (arrow to West bound traffic)

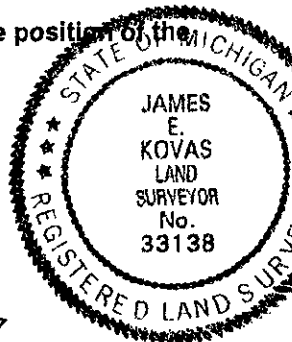

Signed by James E. Kovas Date 12/22/99

Surveyor's Michigan License No. 33138