

LAND CORNER RECORDATION CERTIFICATE
Filing Requirement of Act 74, Mich. P.A. 1970

1979

LIBER 20945 PAGE 574
\$7.00 MISC RECORDING
\$2.00 REMONUMENTATION
01/04/2000 07:37:46 A.M. RECEIPT# 342
PAID RECORDED - OAKLAND COUNTY
G. WILLIAM CADDELL, CLERK/REGISTER OF DEEDS

For corners in

Oakland Located In: Corner Code #
(county)
Holly Township
1. Public Land Survey T 5N R 7E I-12
T R
T R
T R
2. Property Controlling S T R
in Section S T R
3. Miscellaneous S T R
Property in Sec. S T R

Conform with
ACT 343, P.A. 1990

APPROVED ON: 1-5-99 SS
OAKLAND COUNTY REMONUMENTATION
PUBLIC GROUP COMMITTEE
Register of Deeds Stamp & File Number

SECTION

4. Lot No. _____, Recorded Plat _____
5. Private Claims _____

	A	B	C	D	E	F	G	H	I	J	K
2	6	5	4	3	2						
3											
4	7	6	5	4	3	2	1				
5											
6	8	7	6	5	4	3	2	1			
7											
8	9	8	7	6	5	4	3	2	1		
9											
10	10	9	8	7	6	5	4	3	2	1	
11											
12	11	10	9	8	7	6	5	4	3	2	1
13											

I, James E. Kovas, in a field survey on June 5, 1998, do hereby certify that under requirements of P.A. 74, Michigan P.A. of 1970, the corner points mentioned in lines 1 and 2 above were in conformance with regulations and rules therefore as required in the current manual of survey instructions of the United States Department of the Interior, Bureau of Land Management or by a decree of a Court of Law and/or that the corner points mentioned in lines 3, 4 and 5 above were in conformance with the rules of the Michigan Board of Land Surveyors or by a Decree of a Court of Law; established, re-established, monumented, re-monumented, recovered, found as expressed below:

NOTE: Not more than 4 corners, all in the same town and range, may be recorded on this certificate.

A. Description of original monument and accessories and/or subsequent restoration:
I-12

- 1816 - G.L.O., Alex Holmes, D.S., set post
- 1957 - Supervisors Plat No. 10 (Liber 70, Page 35) no monument described
- 1973 - Marvin Pike #11166 (Survey Liber 6307, Page 338) no monument
- 1973 - Marvin Pike #11166 (LCRC Liber 6307, Page 348) found 1-1/4" pipe
- 1992 - Chris Newman #24607 (LCRC Liber 12501, Page 325) found 2" pipe in monument box

Distances: I-12 to I-11 = 2641.37' (Wade-Trim, 1998)

I-12 to I-13 = 2634.12' (Wade-Trim, 1998)

I-12 to I-13 = 2633.80' (Newman, 1988)

B. Description of corner evidence found and/or method applied in restoring or reestablishing corner:

I-12 Found 2" iron pipe in monument box.


WITNESSES FOUND:

- S 8 W 28.0' to power pole found 27.80'
- N 5 E 37.75' to telephone pole found 37.70'
- S 30 W 52.00' to NE corner porch found 52.00'

C. Description of monument for corner and accessories established to perpetuate locating the position of the corner:

I-12 Set remon cap #33138 in found pipe in monument box.

- WIT: N 6 E 22.75' Set 40d nail w/tag #33138 West face fence post
- N 15 E 35.78' Set 40d nail w/tag #33138 East face telephone pole
- N 49 E 77.19' Set 40d nail w/tag #33138 SE face 15" Oak
- S 13 W 27.95' Set 40d nail w/tag #33138 East face power pole
- S 30 W 52.00'+/- NE corner porce #945

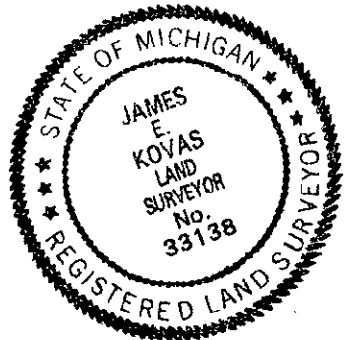

Signed by James E. Kovas

Date 12/23/99

Surveyor's Michigan License No. 33138