

LAND CORNER RECORDATION CERTIFICATE 20945 PAGE 575  
Filing Requirement of Act 74, Mich. P.A. 1970

1970 MISC RECORDING  
\$2.00 REMONUMENTATION  
01/04/2000 07:37:46 A.M. RECEIPT# 342  
PAID RECORDED - OAKLAND COUNTY  
G. WILLIAM CADDELL, CLERK/REGISTER OF DEEDS

For corners in

Oakland Located In: Corner Code #  
(county)  
1. Public Land Survey Holly Township  
T 5N R 7E I-13  
T R  
T R  
T R  
2. Property Controlling S T  
in Section S T  
3. Miscellaneous S T  
Property in Sec. S T

Complies with  
ACT 74, P.A. 1970  
PROVED ON 3-3-99 JS  
OAKLAND COUNTY REGISTER OF DEEDS  
Register of Deeds Stamp & File Number  
MAR 21 2000

4. Lot No. \_\_\_\_\_, Recorded Plat \_\_\_\_\_ SECTION \_\_\_\_\_  
5. Private Claims \_\_\_\_\_

	A	B	C	D	E	F	G	H	I	J	K
2	6		5		4		3		2		
3											
4	7		8		9		10		11		
5											
6	16		17		18		15		14		
7											
8	19		20		21		22		23		
9											
10	30		29		28		27		26		
11											
12	31		32		33		34		35		
13											

I, James E. Kovas in a field survey on November 18, 1998, do hereby certify that under requirements of P.A. 74, Michigan P.A. of 1970, the corner points mentioned in lines 1 and 2 above were in conformance with regulations and rules therefore as required in the current manual of survey instructions of the United States Department of the Interior, Bureau of Land Management or by a decree of a Court of Law and/or that the corner points mentioned in lines 3, 4 and 5 above were in conformance with the rules of the Michigan Board of Land Surveyors or by a Decree of a Court of Law; established, re-established, monumented, re-monumented, recovered, found as expressed below:

NOTE: Not more than 4 corners, all in the same town and range, may be recorded on this certificate.

A. Description of original monument and accessories and/or subsequent restoration:  
I-13  
1816 - G.L.O., Alex Holmes, D.S., set post  
1979 - John Albright #10057 (LCRC Liber 7455, Page 862) found 1" pipe

Distances: I-13 to I-12 = 2634.12' (Wade-Trim, 1998)  
I-13 to I-12 = 2633.80' (Newman, 1988)  
I-13 to H-13 = 2661.36' (Wade-Trim, 1998)  
I-13 to J-13 = 2678.82' (Wade-Trim, 1999)

B. Description of corner evidence found and/or method applied in restoring or reestablishing corner:  
I-13 Found monument with brass cap #24598.


WITNESSES FOUND:

North 2.90' to power pole found 2.88'  
South 56.20' to 12" Boxelder found 56.01'  
S 45 W 38.80' to 15" Cedar found 31.53'

Corner is common to I-1 Rose Township.

C. Description of monument for corner and accessories established to perpetuate locating the position of the corner:  
I-13 Accepted found monument as common corner.

WIT: North 2.88' Set P.K. nail w/tag #33138 power pole  
South 55.93' Set P.K. nail w/tag #33138 12" Boxelder  
S 45 W 32.41' Set P.K. nail w/tag #33138 15" Cedar  
N 35 W 44.92' Set P.K. nail w/tag #33138 fence post

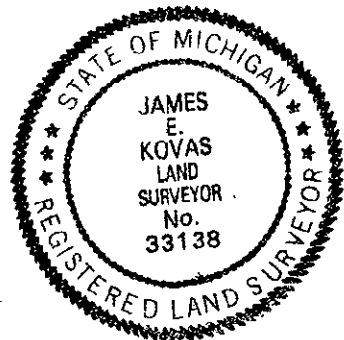

Signed by James E. Kovas Date 12/23/99

Surveyor's Michigan License No. 33138