

LAND CORNER RECORDATION CERTIFICATE
Filing Requirement of Act 74, Mich. P.A. 1970

LIBER 20945 PAGE 576
\$7.00 MISC RECORDING
\$2.00 REMONUMENTATION
01/04/2000 07:37:46 A.M. RECEIPT# 342
PAID RECORDED - OAKLAND COUNTY
G. WILLIAM CADDELL, CLERK/REGISTER OF DEED

For corners in

Oakland Located In: Corner Code #
(county)

- 1. Public Land Survey T 5N R 7E J-1
T ___ R ___
T ___ R ___
T ___ R ___
- 2. Property Controlling S ___ T ___ R ___
in Section S ___ T ___ R ___
- 3. Miscellaneous S ___ T ___ R ___
Property in Sec. S ___ T ___ R ___

SURVEY & RE-MONUMENTATION
WAR 21 2000

RECEIVED ON: 11-3-99 JK
OAKLAND COUNTY REGIONAL...
REGISTER OF DEEDS STAMP & FILE NUMBER

4. Lot No. _____, Recorded Plat _____ SECTION _____

5. Private Claims _____

I, James E. Kovas, in a field survey on December 16, 1998, do hereby certify that under requirements of P.A. 74, Michigan P.A. of 1970, the corner points mentioned in lines 1 and 2 above were in conformance with regulations and rules therefore as required in the current manual of survey instructions of the United States Department of the Interior, Bureau of Land Management or by a decree of a Court of Law and/or that the corner points mentioned in lines 3, 4 and 5 above were in conformance with the rules of the Michigan Board of Land Surveyors or by a Decree of a Court of Law; established, re-established, monumented, re-monumented, recovered, found as expressed below:

	A	B	C	D	E	F	G	H	I	J	K	L
2	6		5		4		3		2			
3												
4	7		8		9		10		11			
5												
6	16		17		18		15		14			
7												
8	19		20		21		22		23			
9												
10	30		29		28		27		26			
11												
12	31		32		33		34		35			
13												

NOTE: Not more than 4 corners, all in the same town and range, may be recorded on this certificate.

A. Description of original monument and accessories and/or subsequent restoration:

J-1
1816 - G.L.O., Alex Holmes, D.S., no post set

- Distances: J-1 to K-1 = 2640.18' (Wade-Trim, 1998)
- J-1 to H-1 = 5261.60' (Wade-Trim, 1999)
- J-1 to J-13 (Grand Blanc Twp.) = 59.58' East (Wade-Trim, 1998)


B. Description of corner evidence found and/or method applied in restoring or reestablishing corner:

J-1 Found wood corner post, fenceline to south and east.
No witnesses found and no records found for this corner. Found iron pin at J-13 (Grand Blanc Twp.) 59.58' east.
Per Peer Review Committee, fence to South will be intersected to North with Township Line between H-13 to K-13.

C. Description of monument for corner and accessories established to perpetuate locating the position of the corner:

J-1 Set concrete monument with tag #33138 on Township line between H-13 and K-13 Grand Blanc Township at intersection of fence extended North.

- WIT: S 80 W 40.36' Set P.K. nail w/tag #33138 18" Ash South face
- N 73 E 11.04' Set P.K. nail w/tag #33138 18" Elm South face
- S 45 E 38.14' Set P.K. nail w/tag #33138 14" Shag Hickory
- S 40 W 16.01' Set P.K. nail w/tag #33138
- East 59.58' Monument Genesee County

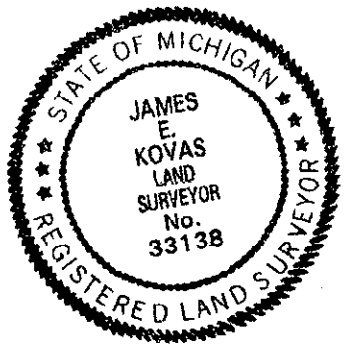

Signed by James E. Kovas Date 12/23/99

Surveyor's Michigan License No. 33138