

LAND CORNER RECORDATION CERTIFICATE
Filing Requirement of Act 74, Mich. P.A. 1970

LIBER 20945 PAGE 577
\$7.00 MISC RECORDING
\$2.00 REMONUMENTATION
01/04/2000 07:37:46 A.M. RECEIPT#
PAID RECORDED - OAKLAND COUNTY
G. WILLIAM CADDELL, CLERK/REGISTER

For corners in

Form with fields for County (Oakland), Located In (Holly Township), Corner Code # (J-3), and various survey types (Public Land Survey, Property Controlling, etc.)

Compliance with ACT 74, P.A. 1970
REMOVED ON 9-20-98 JS
OAKLAND COUNTY COMONUMENTATION
Register of Deeds Stamp & File Number

SECTION

4. Lot No. Recorded Plat
5. Private Claims

I, James E. Kovas, in a field survey on December 15, 1998, do hereby certify that under requirements of P.A. 74, Michigan P.A. of 1970, the corner points mentioned in lines 1 and 2 above were in conformance with regulations and rules...

Grid table with columns A-K and rows 2-13. A dot is marked at the intersection of column J and row 3.

NOTE: Not more than 4 corners, all in the same town and range, may be recorded on this certificate.

A. Description of original monument and accessories and/or subsequent restoration:

- J-3
1816 - G.L.O., Alex Holmes, D.S., set post
1962 - Oakland County Road Commission (set 1" diameter pipe)
1990 - Chris Newman #24607 (LCRC Liber 11604, Page 653) found 3/4" pipe
1995 - Grant Ward #22445 (LCRC Liber 15691, Page 819) found 3/4" pipe 1.5' south of centerline of road

Distances: J-3 to I-3 = 2649.29' (Wade-Trim, 1998)

J-3 to K-3 = 2629.19' (Wade-Trim, 1999)
J-3 to K-3 = 2629.45' (Newman, 1992)

B. Description of corner evidence found and/or method applied in restoring or reestablishing corner:

J-3 Found 3/4" iron pipe.

WITNESSES FOUND:


Table listing witness findings: NW 45.93' to 7" Oak new nail found 47.22', NE 37.45' to 14" Oak new nail found 37.21', North 20.75' to 5" Hickory found 20.72', N 45 E 37.85' to P.K. in 36" Oak found 37.21' new nail, N 67 W 45.93' to tag in 12" Oak found 47.22', South 33.00' to 1/2" rerod with cap found 33.12', N 45 E 37.85' to found P.K. in 36" Oak found 37.21', N 67 W 45.93' to found nail and tag in 12" Oak found 47.22' new nail, South 33.00' to found 1/2" rerod with cap found 33.12'

lp
n

C. Description of monument for corner and accessories established to perpetuate locating the position of the corner:

J-3 Found 3/4" iron pipe in centerline Belford fence line going South. Removed and replaced with concrete monument with cap #33138.

- WIT: N 20 W 47.25' Set nail w/tag #33138 18" Oak
N 25 E 20.70' Set nail w/tag #33138 10" Oak
N 55 E 36.85' Set nail w/tag #33138 24" Oak
S 20 W 20.86' Set nail w/tag #33138 8" Oak

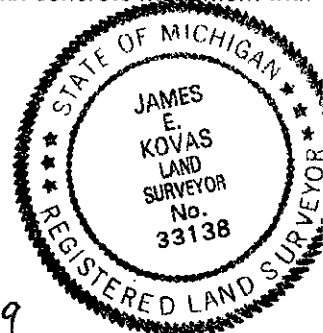

Signed by James E. Kovas

Date 12/22/99

Surveyor's Michigan License No. 33138