

LAND CORNER RECORDATION CERTIFICATE
Filing Requirement of Act 74, Mich. P.A. 1970

LIBER 20945 PAGE 579
\$7.00 MISC RECORDING
\$2.00 REMONUMENTATION
01/04/2000 07:37:46 A.M. RECEIPT# 342
PAID RECORDED - OAKLAND COUNTY
G. WILLIAM CABELL, CLERK/REGISTER OF DEEDS

For corners in

Oakland Located In: Holly Township Corner Code #
(county)
1. Public Land Survey T 5N R 7E J-9
T R
T R SURVEY &
T R RE-ESTABLISHMENT
2. Property Controlling S T R
in Section S T R
3. Miscellaneous S T R
Property in Sec. S T R MAR 21 2000

Register of Deeds Stamp & File Number

SECTION

4. Lot No. _____, Recorded Plat _____

5. Private Claims _____

I, James E. Kovas, in a field survey on December 11, 1998, do hereby certify that under requirements of P.A. 74, Michigan P.A. of 1970, the corner points mentioned in lines 1 and 2 above were in conformance with regulations and rules therefore as required in the current manual of survey instructions of the United States Department of the Interior, Bureau of Land Management or by a decree of a Court of Law and/or that the corner points mentioned in lines 3, 4 and 5 above were in conformance with the rules of the Michigan Board of Land Surveyors or by a Decree of a Court of Law; established, re-established, monumented, re-monumented, recovered, found as expressed below:

	A	B	C	D	E	F	G	H	I	J	K
2	1	2	3	4	5	6	7	8	9	10	11
3											
4	12	13	14	15	16	17	18	19	20	21	22
5											
6	23	24	25	26	27	28	29	30	31	32	33
7											
8	34	35	36	37	38	39	40	41	42	43	44
9											
10	45	46	47	48	49	50	51	52	53	54	55
11											
12	56	57	58	59	60	61	62	63	64	65	66
13											

NOTE: Not more than 4 corners, all in the same town and range, may be recorded on this certificate.

A. Description of original monument and accessories and/or subsequent restoration:

J-9
1816 - G.L.O., Alex Holmes, D.S., set post

Distances: J-9 to K-9 = 2648.24' (Wade-Trim, 1998)
J-9 to K-9 = 2649.30' (Newman, 1997)
J-9 to I-9 = 2654.98' (Wade-Trim, 1998)

B. Description of corner evidence found and/or method applied in restoring or reestablishing corner:

J-9 Found 1/2" iron with cap #24607.


WITNESSES FOUND:

N 10 W 13.80' to set nail in 10" Elm found 13.86'
N 85 E 27.65' to set nail in 12" Beech found 27.60'
S 20 E 26.40' to set nail in 6" Cherry found 26.34'

C. Description of monument for corner and accessories established to perpetuate locating the position of the corner:

J-9 Found 1/2" iron and cap #24607. Removed and replaced with concrete cap #33138.

WIT: N 15 W 13.79' Set nail w/tag #33138 8" Oak West face
West 20.89' Set nail w/tag #33138 6" Elm North face
S 14 E 26.34' Set nail w/tag #33138 6" Cherry West face
East 27.66' Set nail w/tag #33138 12" Maple South face

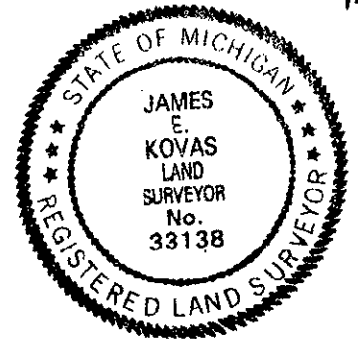

Signed by James E. Kovas

Date 12/22/99

Surveyor's Michigan License No. 33138