

LAND CORNER RECORDATION CERTIFICATE
Filing Requirement of Act 74, Mich. P.A. 1970

LIBER 20945 PAGE 580
\$7.00 MISC RECORDING
\$2.00 REMONUMENTATION
01/04/2000 07:37:46 A.M. RECEIPT# 342
PAID RECORDED - OAKLAND COUNTY
G. WILLIAM CABELL, CLERK/REGISTER OF DEEDS

For corners in

<u>Oakland</u> (county)	Located In:	Corner Code #
	Holly Township	
1. Public Land Survey	T <u>5N</u> R <u>7E</u>	<u>J-11</u>
	T _____ R _____	<u>SURVEY &</u>
	T _____ R _____	<u>REMONUMENTATION</u>
	T _____ R _____	
2. Property Controlling in Section	S _____ T _____ R _____	<u>MAR 21 2000</u>
3. Miscellaneous Property in Sec.	S _____ T _____ R _____	
	S _____ T _____ R _____	<u>SECTION</u>

Register of Deeds Stamp & File Number

4. Lot No. _____, Recorded Plat _____
5. Private Claims _____

	A	B	C	D	E	F	G	H	I	J	K
2	6	5	4	3	2						
3											
4	7	8	9	10	11						
5											
6	16	17	16	15	14						
7											
8	19	20	21	22	23						
9											
10	30	29	28	27	26						
11											
12	31	32	33	34	35						
13											

I, James E. Kovas, in a field survey on October 29, 1998, do hereby certify that under requirements of P.A. 74, Michigan P.A. of 1970, the corner points mentioned in lines 1 and 2 above were in conformance with regulations and rules therefore as required in the current manual of survey instructions of the United States Department of the Interior, Bureau of Land Management or by a decree of a Court of Law and/or that the corner points mentioned in lines 3, 4 and 5 above were in conformance with the rules of the Michigan Board of Land Surveyors or by a Decree of a Court of Law; established, re-established, monumented, re-monumented, recovered, found as expressed below:

NOTE: Not more than 4 corners, all in the same town and range, may be recorded on this certificate.

A. Description of original monument and accessories and/or subsequent restoration:

- J-11
- 1816 - G.L.O., Alex Holmes, D.S., set post
- 1978 - John D. Albright #10057 (Liber 7399, Page 443 and Liber 10668, Page 300)
- 1985 - Chris Newman #24607 (Liber 8901, Page 475 and Page 494 and Page 500) found 1/2" rerod at corner post
- 1990 - Chris Newman #24607 (LCRC Liber 11604, Page 651 and an unrecorded survey) found 1/2" rerod

- Distances:
- J-11 to K-11 = 2662.77' (Wade-Trim, 1998)
 - J-11 to K-11 = 2656.02' (Wade-Trim, 1998)
 - J-11 to K-11 = 2656.73' (Newman, 1990)
 - J-11 to K-11 = 2656.73' (Tax map)

B. Description of corner evidence found and/or method applied in restoring or reestablishing corner:

J-11 Found 1/2" iron in wood post.

This corner is in a swamp. After digging down along side the wood post, we found that it has been pointed with an axe. It is apparently the original GLO post. The top had rotted off. The post was about six inches in diameter.

WITNESSES FOUND:


- N 10 E 58.22' to 12" Maple found 58.60'
- N 45 E 61.00' to 27" Oak found 60.98'
- East 262.42' to Tri-County iron found 262.52'
- N 10 E 58.46' to 12" Maple found 58.60'
- N 20 E 55.15' to 14" Maple found 55.25'

C. Description of monument for corner and accessories established to perpetuate locating the position of the corner:

J-11 Found 1/2" iron in wood post. Removed and replaced with 5/8" iron 24" long with cap #33138.

- WIT:
- N 10 E 58.60' Set nail w/tag #33138 12" Oak West face
 - N 30 E 55.25' Set nail w/tag #33138 12" Maple East face
 - N 45 E 60.98' Set nail w/tag #33138 27" Oak East face

Note: 35+/- in swamp
East 27.66' Set nail w/tag #33138 12" Maple South face

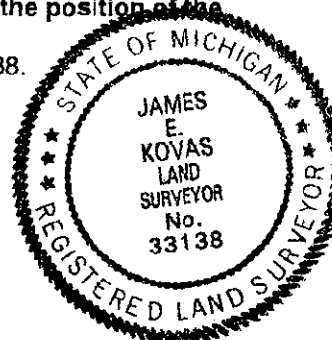

Signed by James E. Kovas Date 12/22/99

Surveyor's Michigan License No. 33138