

LAND CORNER RECORDATION CERTIFICATE  
Filing Requirement of Act 74, Mich. P.A. 1970

1986

For corners in

Oakland Located in: Corner Code #  
(county)  
1. Public Land Survey Holly Township  
T 5N R 7E J-13  
T \_\_\_ R \_\_\_  
T \_\_\_ R \_\_\_  
T \_\_\_ R \_\_\_  
2. Property Controlling S \_\_\_ T \_\_\_ R \_\_\_  
in Section S \_\_\_ T \_\_\_ R \_\_\_  
3. Miscellaneous S \_\_\_ T \_\_\_ R \_\_\_  
Property in Sec. S \_\_\_ T \_\_\_ R \_\_\_

LIBER 20945 PAGE 581  
\$7.00 MISC RECORDING  
\$2.00 REMONUMENTATION  
01/04/2000 07:37:46 A.M. RECEIPT# 342  
PAID RECORDED - OAKLAND COUNTY  
G. WILLIAM CABDELL, CLERK/REGISTER OF DEEDS

APPROVED BY  
ACT 74, P.A. 1970  
3-31-99 JS  
OAKLAND COUNTY REGISTER OF DEEDS  
Register of Deeds Stamp & File Number

SECTION

4. Lot No. \_\_\_\_\_, Recorded Plat \_\_\_\_\_  
5. Private Claims \_\_\_\_\_

	A	B	C	D	E	F	G	H	I	J	K
2	6		5		4		3		2		
3											
4	7		8		9		10		11		
5											
6	16		17		16		15		14		
7											
8	19		20		21		22		23		
9											
10	30		29		28		27		26		
11											
12	31		32		33		34		35		
13											

I, James E. Kovas in a field survey on October 28, 1998, do hereby certify that under requirements of P.A. 74, Michigan P.A. of 1970, the corner points mentioned in lines 1 and 2 above were in conformance with regulations and rules therefore as required in the current manual of survey instructions of the United States Department of the Interior, Bureau of Land Management or by a decree of a Court of Law and/or that the corner points mentioned in lines 3, 4 and 5 above were in conformance with the rules of the Michigan Board of Land Surveyors or by a Decree of a Court of Law; established, re-established, monumented, re-monumented, recovered, found as expressed below:

NOTE: Not more than 4 corners, all in the same town and range, may be recorded on this certificate.

A. Description of original monument and accessories and/or subsequent restoration:

J-13  
1816 - G.L.O., Alex Holmes, D.S., set post

Distances: J-13 to I-13 = 2678.82' (Wade-Trim, 1999)

J-13 to I-13 = 2678.82' (Wade-Trim, 1999)

B. Description of corner evidence found and/or method applied in restoring or reestablishing corner:


J-13 No monument or possession evidence ofund, corner is in swamp.

There is no evidence in the record of surveys to this corner. We propose to use the split of the distance between I-13 and K-13 and place the corner on lin, at half the distance.

C. Description of monument for corner and accessories established to perpetuate locating the position of the corner:

J-13 Re-established per peer location. Placed concrete monument with cap #33138.

WIT: N 8 W 57.83' Set P.K. nail w/tag #33138 10" Oak  
N 40 W 49.74' Set P.K. nail w/tag #33138 10" Oak  
S 85 W 27.58' Set P.K. nail w/tag #33138 5" Birch

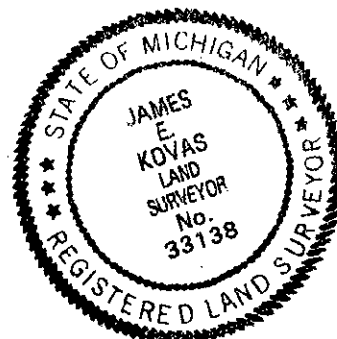

Signed by James E. Kovas Date 12/22/99

Surveyor's Michigan License No. 33138