

LAND CORNER RECORDATION CERTIFICATE  
Filing Requirement of Act 74, Mich. P.A. 1970

LIBER 20945 PAGE 582  
\$7.00 MISC RECORDING  
\$2.00 REMONUMENTATION  
01/04/2000 07:37:46 A.M. RECEIPT# 342  
PAID RECORDED - OAKLAND COUNTY  
G. WILLIAM CABELL, CLERK/REGISTER OF DEEDS

For corners in

|                                    |                |               |
|------------------------------------|----------------|---------------|
| <u>Oakland</u><br>(county)         | Located In:    | Corner Code # |
|                                    | Holly Township |               |
| 1. Public Land Survey              | T 5N R 7E      | K-1           |
|                                    | T R            |               |
|                                    | T R            |               |
|                                    | T R            |               |
| 2. Property Controlling in Section | S T R          |               |
|                                    | S T R          |               |
| 3. Miscellaneous Property in Sec.  | S T R          |               |
|                                    | S T R          |               |

RECEIVED ON: 1-3-99 55  
OAKLAND COUNTY REGISTER OF DEEDS

Register of Deeds Stamp & File Number

SECTION

4. Lot No. \_\_\_\_\_, Recorded Plat \_\_\_\_\_

5. Private Claims \_\_\_\_\_

I, James E. Kovas, in a field survey on November 20, 1998, do hereby certify that under requirements of P.A. 74, Michigan P.A. of 1970, the corner points mentioned in lines 1 and 2 above were in conformance with regulations and rules therefore as required in the current manual of survey instructions of the United States Department of the Interior, Bureau of Land Management or by a decree of a Court of Law and/or that the corner points mentioned in lines 3, 4 and 5 above were in conformance with the rules of the Michigan Board of Land Surveyors or by a Decree of a Court of Law; established, re-established, monumented, re-monumented, recovered, found as expressed below:

| A  | B  | C  | D  | E  | F  | G | H | I | J | K |
|----|----|----|----|----|----|---|---|---|---|---|
| 2  | 6  | 5  | 4  | 3  | 2  |   |   |   |   |   |
| 3  |    |    |    |    |    |   |   |   |   |   |
| 4  | 7  | 8  | 9  | 10 | 11 |   |   |   |   |   |
| 5  |    |    |    |    |    |   |   |   |   |   |
| 6  | 16 | 17 | 18 | 15 | 14 |   |   |   |   |   |
| 7  |    |    |    |    |    |   |   |   |   |   |
| 8  | 19 | 20 | 21 | 22 | 23 |   |   |   |   |   |
| 9  |    |    |    |    |    |   |   |   |   |   |
| 10 | 30 | 29 | 28 | 27 | 26 |   |   |   |   |   |
| 11 |    |    |    |    |    |   |   |   |   |   |
| 12 | 31 | 32 | 33 | 34 | 35 |   |   |   |   |   |
| 13 |    |    |    |    |    |   |   |   |   |   |

NOTE: Not more than 4 corners, all in the same town and range, may be recorded on this certificate.

A. Description of original monument and accessories and/or subsequent restoration:

- K-1
- 1816 - G.L.O., Alex Holmes, D.S., post set
- 1973 - Karol Piotrowski #9685 (LCRC Liber 6203, Page 430) set 1" pipe at intersection of extension of West line and North line of section

- Distances:
- K-1 to K-2 = 2873.11' (Wade-Trim, 1999)
  - K-1 to K-2 = 2873.70' (Piotrowski, 1973)
  - K-1 to L-1 = 2692.12' (Wade-Trim, 1998)
  - K-1 to L-1 = 2691.64' (Piotrowski, 1973)
  - K-1 to J-1 = 2640.18' (Wade-Trim, 1998)

- K-1 to K-13 (Grand Blanc Township) 64.24' East (Wade-Trim, 1998)
- K-1 to K-13 (Grand Blanc Township) 71.39' East (Piotrowski, 1973)
- K-1 to K-13 (Grand Blanc Township) 64.28' East (Gould, 1999)

B. Description of corner evidence found and/or method applied in restoring or reestablishing corner:


K-1 Found 1/2" iron with cap #10057 in rock pile on edge of stream.

The distance from this 1/2" iron to the iron at K-13 (Grand Blanc) was measured to be 64.24'.

C. Description of monument for corner and accessories established to perpetuate locating the position of the corner:

K-1 Found 1/2" iron cap #24607 in rock pile edge on canal. Removed and replaced with concrete monument cap #33138.

- WIT:
- East 8.41' Set nail w/tag #33138 12" Elm South face
  - North 25.18' Set nail w/tag #33138 6" Elm East face
  - N 60 W 58.75' Set nail w/tag #33138 6" Maple South face
  - N 75 W 29.98' Set nail w/tag #33138 8" Maple North face

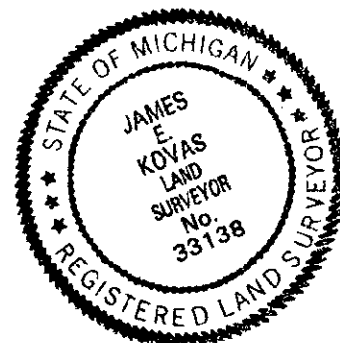

Signed by James E. Kovas

Date 12/23/99

Surveyor's Michigan License No. 33138