

LAND CORNER RECORDATION CERTIFICATE
Filing Requirement of Act 74, Mich. P.A. 1970

For corners in

Oakland Located In: Corner Code #
(county)

Holly Township

1. Public Land Survey T 5N R 7E SECTION
T R REESTABLISHMENT
T R MAR 21 2000
T R
2. Property Controlling S T R
in Section S T R
3. Miscellaneous S T R
Property in Sec. S T R SECTION

1990

LIBER 20945 PAGE 585
\$7.00 MISC RECORDING
\$2.00 REMONUMENTATION
01/04/2000 07:37:46 A.M. RECEIPT# 342
PAID RECORDED - OAKLAND COUNTY
G. WILLIAM CADDELL, CLERK/REGISTER OF DEEDS
ACTS 207, 208, 1999

RECORDED ON: 9-23-98 JS
OAKLAND COUNTY REGISTER OF DEEDS

Register of Deeds Stamp & File Number

4. Lot No. _____, Recorded Plat _____

5. Private Claims _____

I, James E. Kovas, in a field survey on August 5, 1998, do hereby certify that under requirements of P.A. 74, Michigan P.A. of 1970, the corner points mentioned in lines 1 and 2 above were in conformance with regulations and rules therefore as required in the current manual of survey instructions of the United States Department of the Interior, Bureau of Land Management or by a decree of a Court of Law and/or that the corner points mentioned in lines 3, 4 and 5 above were in conformance with the rules of the Michigan Board of Land Surveyors or by a Decree of a Court of Law; established, re-established, monumented, re-monumented, recovered, found as expressed below:

A	B	C	D	E	F	G	H	I	J	K
2	6	5	4	3	2					
3										
4	7	8	9	10	11					
5										
6	18	17	16	15	14					
7										
8	19	20	21	22	23					
9										
10	30	29	28	27	26					
11										
12	31	32	33	34	35					
13										

NOTE: Not more than 4 corners, all in the same town and range, may be recorded on this certificate.

A. Description of original monument and accessories and/or subsequent restoration:
K-4
1816 - G.L.O., Alex Holmes, D.S., set post
1992 - Chris Newman #24607 (LCRC Liber 13294, Page 134) found 1/2" rerod
1995 - Grant Ward #22445 (LCRC Liber 15691, Page 819) found iron rod and cap #10057 and #24607

Distances: K-4 to K-3 = 2644.89' (Wade-Trim, 1998)
K-4 to K-3 = 2644.81' (Newman, 1992)
K-4 to K-5 = 2669.27' (Wade-Trim, 1998)

B. Description of corner evidence found and/or method applied in restoring or reestablishing corner:
K-4 Found 1/2" iron rod.


WITNESSES FOUND:

N 75 E	8.47'	to 15" Oak	found	8.80'
S 5 E	14.60'	to 12" Maple	found	14.45'
S 80 W	8.97'	to 18" Ash	found	8.94'
S 80 E	30.13'	to 15" Ash	found	gone
N 60 E	8.74'	to found nail and disc in South face 16" Oak	found	8.80'
South	14.43'	to set P.K. and disc 22445 in East face 14" Maple	found	14.45'
S 70 W	8.91'	to set P.K. and disc 22445 in South face of 18" Oak	found	8.94'
N 45 W	13.18'	to set P.K. and disc 22445 in East face 4" Elm	found	13.18'

C. Description of monument for corner and accessories established to perpetuate locating the position of the corner:

K-4 Found 1/2" iron cap #10057. Set concrete monument with remon cap #33138.

WIT: N 60 E 8.92' Set P.K./tag #33138 NW face 18" Oak
South 14.40' Set P.K./tag #33138 East face 14" Oak
S 70 W 8.77' Set P.K./tag #33138 South face 18" Oak
N 34 W 35.84' Set P.K./tag #33138 East face 14" Oak

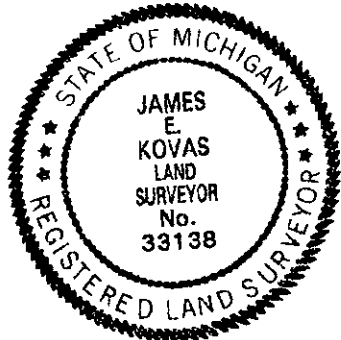

Signed by James E. Kovas Date 12/23/99

Surveyor's Michigan License No. 33138