

LAND CORNER RECORDATION CERTIFICATE
Filing Requirement of Act 74, Mich. P.A. 1970

1991

For corners in

<u>Oakland</u> (county)	Located In:	Corner Code #
	Holly Township	
1. Public Land Survey	T <u>5N</u> R <u>7E</u>	<u>K-5</u>
	T _____ R _____	_____
	T _____ R _____	_____
2. Property Controlling in Section	S _____ T _____	_____
3. Miscellaneous Property in Sec.	S _____ T _____	_____

LIBER 20945 PAGE 586
 \$7.00 MISC RECORDING
 \$2.00 REMONUMENTATION
 01/04/2000 07:37:46 A.M. RECEIPT# 342
 PAID RECORDED - OAKLAND COUNTY
 G. WILLIAM CADDELL, CLERK/REGISTER OF

RECEIVED ON
 ACTUAL DATE 1999

3-3-99 SK
 REGISTER OF DEEDS STAMP & FILE NUMBER

SECTION

4. Lot No. _____, Recorded Plat _____

5. Private Claims _____

I, James E. Kovas, in a field survey on August 5, 1998, do hereby certify that under requirements of P.A. 74, Michigan P.A. of 1970, the corner points mentioned in lines 1 and 2 above were in conformance with regulations and rules therefore as required in the current manual of survey instructions of the United States Department of the Interior, Bureau of Land Management or by a decree of a Court of Law and/or that the corner points mentioned in lines 3, 4 and 5 above were in conformance with the rules of the Michigan Board of Land Surveyors or by a Decree of a Court of Law; established, re-established, monumented, re-monumented, recovered, found as expressed below:

A	B	C	D	E	F	G	H	I	J	K
2	6	5	4	3	2					
3										
4	7	8	9	10	11					
5										
6	18	17	16	15	14					
7										
8	19	20	21	22	23					
9										
10	30	29	28	27	26					
11										
12	31	32	33	34	35					
13										

NOTE: Not more than 4 corners, all in the same town and range, may be recorded on this certificate.

A. Description of original monument and accessories and/or subsequent restoration:

- K-5
- 1816 - G.L.O., Alex Holmes, D.S., set post
- 1962 - Oakland County Road Commission (found 1/2" diameter pipe)
- 1978 - James Smith #21582 (Survey Liber 7218, Page 478) iron found (by legend)
- 1979 - John Albright #10057 (LCRC Liber 7455, Page 860) found 1/2" rerod
- 1992 - James Scharl #19843 (LCRC Liber 12747, Page 018) found 3/8" rerod in centerline of Lahring Road

- Distances:
- K-5 to K-4 = 2669.27' (Wade-Trim, 1998)
 - K-5 to L-5 = 2691.82' (Wade-Trim, 1999)
 - K-5 to K-6 = 2630.80' (Wade-Trim, 1999)
 - K-5 to J-5 = J-5 is in a Lake

B. Description of corner evidence found and/or method applied in restoring or reestablishing corner:

K-5 Found 1/2" iron rod. Verified by found 1/2" iron to east (T. Smith #31606) 412.36' (M) 412.40' (R)


WITNESSES FOUND:

NE	25.81'	to 10" Oak	found	diff. nail	23.89'
S 30 E	22.45'	to fence post	found		22.53'
N 35 W	30.24'	to P.K. nail SW side of 8" Maple	found		30.22'
N 3 W	29.08'	to P.K. nail in East side 8" Hickory	found		29.12'
N 25 E	23.86'	to P.K. nail SE side 14" Oak	found		23.89'
S 55 E	22.54'	to corner post of 8' cyclone fence	found		22.53'

C. Description of monument for corner and accessories established to perpetuate locating the position of the corner:

K-5 Found 1/2" iron at centerline Lahring Road. Set remon cap #33138.

- WIT:
- N 23 E 24.04' Set P.K./tag #33138 SE face 14" Oak
 - N 03 W 29.11' Set P.K./tag #33138 East face 10" Oak
 - N 36 W 30.32' Set P.K./tag #33138 SW face 12" Maple
 - S 45 E 62.11' Set P.K./tag #33138 NE face 24" Oak

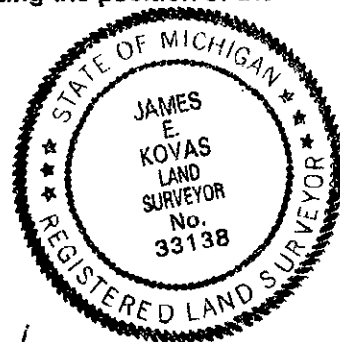

Signed by James E. Kovas Date 12/22/99

Surveyor's Michigan License No. 33138