

LAND CORNER RECORDATION CERTIFICATE
Filing Requirement of Act 74, Mich. P.A. 1970

1993

For corners in

Oakland
(county)

Located In: Corner Code #

1. Public Land Survey

Holly Township
T 5N R 7E K-8

2. Property Controlling
in Section

S T R
S T R
S T R
S T R

3. Miscellaneous
Property in Sec.

S T R
S T R
S T R
S T R

4. Lot No. _____, Recorded Plat SECTION

5. Private Claims _____

I, James E. Kovas, in a field survey on December 15, 1998, do hereby certify that under requirements of P.A. 74, Michigan P.A. of 1970, the corner points mentioned in lines 1 and 2 above were in conformance with regulations and rules therefore as required in the current manual of survey instructions of the United States Department of the Interior, Bureau of Land Management or by a decree of a Court of Law and/or that the corner points mentioned in lines 3, 4 and 5 above were in conformance with the rules of the Michigan Board of Land Surveyors or by a Decree of a Court of Law; established, re-established, monumented, re-monumented, recovered, found as expressed below:

NOTE: Not more than 4 corners, all in the same town and range, may be recorded on this certificate.

A. Description of original monument and accessories and/or subsequent restoration:
K-8

1816 - G.L.O., Alex Holmes, D.S., set post
1990 - Chris Newman #24607 (LCRC Liber 11604, Page 652) found "T" iron #7434

Distances: K-8 to K-9 = 2649.96' (Wade-Trim, 1998)

K-8 to K-7 = 2651.18' (Wade-Trim, 1999)

B. Description of corner evidence found and/or method applied in restoring or reestablishing corner:

K-8 Found "T" iron.

WITNESSES FOUND:

South 7.70' to 15" Elm found 7.68'
West 36.25' to found 1/2" iron found 36.09'
N 15 E 41.40' to 6" Beech found 41.50'

C. Description of monument for corner and accessories established to perpetuate locating the position of the corner:

K-8 Found "T" iron East edge of Private Drive. Removed and replaced with concrete monument cap #33138.


WIT: N 50 E 18.04' Set nail w/tag #33138 West face 36" Oak
South 7.72' Set nail w/tag #33138 West face 14" Elm
West 36.09' Found iron in fence line
N W 26.53' Set nail w/tag #33138 North face 36" Oak
N E 41.32' Set nail w/tag #33138 East face 6" Beech

LIBER 20945 PAGE 588
\$7.00 MISC RECORDING
\$2.00 REMONUMENTATION
01/04/2000 07:37:46 A.M. RECEIPT# 342
PAID RECORDED - OAKLAND COUNTY
G. WILLIAM CADDELL, CLERK/REGISTER OF DEED

APPROVED ON 1-5-99 JS

Register of Deeds Stamp & File Number

| | A | B | C | D | E | F | G | H | I | J | K | L |
|----|----|----|----|----|----|---|---|---|---|---|---|---|
| 2 | 6 | 5 | 4 | 3 | 2 | 1 | | | | | | |
| 3 | | | | | | | | | | | | |
| 4 | 7 | 8 | 9 | 10 | 11 | 1 | | | | | | |
| 5 | | | | | | | | | | | | |
| 6 | 18 | 17 | 16 | 15 | 14 | 1 | | | | | | |
| 7 | | | | | | | | | | | | |
| 8 | 19 | 20 | 21 | 22 | 23 | 2 | | | | | | |
| 9 | | | | | | | | | | | | |
| 10 | 30 | 29 | 28 | 27 | 26 | 2 | | | | | | |
| 11 | | | | | | | | | | | | |
| 12 | 31 | 32 | 33 | 34 | 35 | 3 | | | | | | |
| 13 | | | | | | | | | | | | |

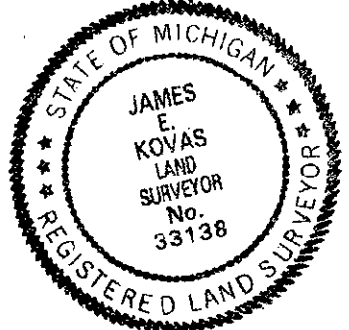

Signed by James Kovas Date 12/23/99

Surveyor's Michigan License No. 33138