

LAND CORNER RECORDATION CERTIFICATE  
Filing Requirement of Act 74, Mich. P.A. 1970

1994

For corners in

Oakland Located In: Holly Township Corner Code # K-9  
(county)

1. Public Land Survey T 5N R 7E K-9  
T     R          
T     R          
T     R        

2. Property Controlling S     T     R          
in Section S     T     R        

3. Miscellaneous S     T     R          
Property in Sec. S     T     R        

LIBER 20945 PAGE 589  
\$7.00 MISC RECORDING  
\$2.00 REMONUMENTATION  
01/04/2000 07:37:46 A.M. RECEIPT# 342  
PAID RECORDED - OAKLAND COUNTY  
S. WILLIAM CADDELL, CLERK/REGISTER OF DEEDS

Complied with  
ACT 345, P.A. 1990

APPROVED ON: 1-5-99 JS  
OAKLAND COUNTY REMONUMENTATION  
Register of Deeds Stamp & File Number

SECTION

4. Lot No. \_\_\_\_\_, Recorded Plat \_\_\_\_\_

5. Private Claims \_\_\_\_\_

I, James E. Kovas, in a field survey on October 20, 1998, do hereby certify that under requirements of P.A. 74, Michigan P.A. of 1970, the corner points mentioned in lines 1 and 2 above were in conformance with regulations and rules therefore as required in the current manual of survey instructions of the United States Department of the Interior, Bureau of Land Management or by a decree of a Court of Law and/or that the corner points mentioned in lines 3, 4 and 5 above were in conformance with the rules of the Michigan Board of Land Surveyors or by a Decree of a Court of Law; established, re-established, monumented, re-monumented, recovered, found as expressed below:

	A	B	C	D	E	F	G	H	I	J	K
2	6	5	4	3	2						
3											
4	7	8	9	10	11						
5											
6	18	17	16	15	14						
7											
8	19	20	21	22	23						
9											
10	30	29	28	27	26						
11											
12	31	32	33	34	35						
13											

NOTE: Not more than 4 corners, all in the same town and range, may be recorded on this certificate.

A. Description of original monument and accessories and/or subsequent restoration:

- K-9
- 1816 - G.L.O., Alex Holmes, D.S., set post
- 1973 - D. Scott #12029 (LCRC Liber 6073, Page 759) found 3/8" iron pin tied to Great Lakes Sub. Placed plastic cap #12029 on pin
- 1996 - Tim Hart #33136 (LCRC Liber 16651, Page 453) found iron and cap #12029


Distances: K-9 to L-9 = 2688.44' (Wade-Trim, 1998)      K-9 to K-10 = 2609.28' (Wade-Trim, 1999)  
K-9 to K-8 = 2649.96' (Wade-Trim, 1998)  
K-9 to J-9 = 2648.24' (Wade-Trim, 1998)  
K-9 to J-9 = 2649.30' (Newman, 1997)

B. Description of corner evidence found and/or method applied in restoring or reestablishing corner:

K-9 Found 1/2" iron.  
South 36.49' (36.48' R) to found iron at SW corner of Lot 7  
North 13.15' (13.52' R) to found iron NW corner of Lot 7

WITNESSES FOUND:

S 40 E 10.79' to 4" Oak	found	10.78'
N 15 E 26.69' to 18" Oak (1 of 3 in clump)	found	26.70'
South 36.48' to property corner SW corner of Lot 7, Block 13	found	36.49'
S 40 E 10.79' to P.K. in 6" Oak	found	10.78'
N 15 E 26.69' to P.K. in 20" Oak in Clump	found	26.70'
South 36.48' to SW corner of Lot 7	found	36.49'

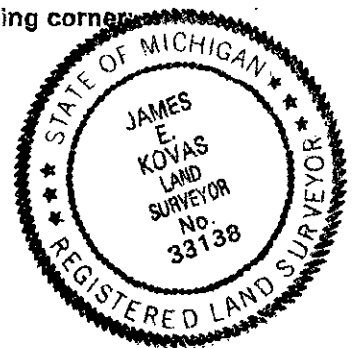

C. Description of monument for corner and accessories established to perpetuate locating the position of the corner:

K-9 Found 1/2" iron. Removed and replaced with concrete monument cap #33138.

WIT: North 13.15' Iron Lot #7  
N 30 E 26.70' Set P.K. nail w/tag #33138 28" Oak West face  
S 30 E 10.78' Set P.K. nail w/tag #33138 6" Oak NW face  
S 10 E 18.80' Set P.K. nail w/tag #33138 28" Oak West face  
South 36.49' Iron Lot 7 SW corner  
N 20 W 30.45' Set P.K. nail w/tag #33138 10" Maple NW face

Signed by James E. Kovas

Date 12/23/99

Surveyor's Michigan License No. 33138