

LAND CORNER RECORDATION CERTIFICATE  
Filing Requirement of Act 74, Mich. P.A. 1970

For corners in

1995

Oakland Located In: Holly Township Corner Code # K-11  
(county)

1. Public Land Survey T 5N R 7E SECTION  
T R  
T R  
T R

2. Property Controlling S T R  
in Section S T R MAR 21 2000  
3. Miscellaneous S T R  
Property in Sec. S T R

LIBER 20945 PAGE 590  
\$7.00 MISC RECORDING  
\$2.00 RENOVATION  
01/04/2000 07:37:46 A.M. RECEIPT# 342  
PAID RECORDED - OAKLAND COUNTY  
G. WILLIAM CADDELL, CLERK/REGISTER OF DEED  
10-28-98 JS  
Register of Deeds Stamp & File Number

4. Lot No. \_\_\_\_\_, Recorded Plat \_\_\_\_\_  
5. Private Claims \_\_\_\_\_

A	B	C	D	E	F	G	H	I	J	K	L
2	6	5	4	3	2						
3											
4	7	8	9	10	11	1					
5											
6	18	17	16	15	14	1					
7											
8	19	20	21	22	23	2					
9											
10	30	29	28	27	26	2					
11											
12	31	32	33	34	35	3					
13											


I, James E. Kovas, in a field survey on September 9, 1998, do hereby certify that under requirements of P.A. 74, Michigan P.A. of 1970, the corner points mentioned in lines 1 and 2 above were in conformance with regulations and rules therefore as required in the current manual of survey instructions of the United States Department of the Interior, Bureau of Land Management or by a decree of a Court of Law and/or that the corner points mentioned in lines 3, 4 and 5 above were in conformance with the rules of the Michigan Board of Land Surveyors or by a Decree of a Court of Law; established, re-established, monumented, re-monumented, recovered, found as expressed below:

NOTE: Not more than 4 corners, all in the same town and range, may be recorded on this certificate.

A. Description of original monument and accessories and/or subsequent restoration:

- K-11
- 1816 - G.L.O., Alex Holmes, D.S., set post
- 1978 - John Albright #10057 (LCRC Liber 7399, Page 431) found 3" steel post
- 1982 - Gary Bilow #26453 (Survey Liber 8250, Page 356 and LCRC Liber 8250, Page 357) DNR monument (near base of steep bank, 20' East of Lakeshore)
- 1996 - Grant Ward #22445 (LCRC Liber 16719, Page 045) found DNR monument

- Distances:
- K-11 to K-10 = 2609.28' (Wade-Trim, 1998)
  - K-11 to K-12 = 2636.68' (Wade-Trim, 1998)
  - K-11 to J-11 = 2662.77' (Wade-Trim, 1999)
  - K-11 to L-11 = 2654.68' (Wade-Trim, 1998)
  - K-11 to L-11 = 2655.08' (Bilow, 1982)

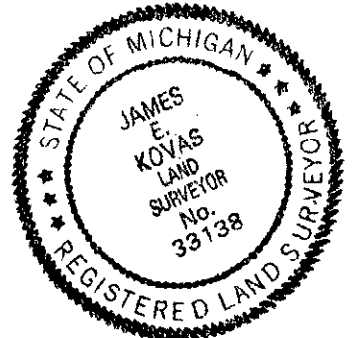

B. Description of corner evidence found and/or method applied in restoring or reestablishing corner:

K-11 Found DNR monument.

WITNESSES FOUND:

S 55 E	14.39'	to spike and tag in 8" Hickory	found	14.18'
S 83 E	5.81'	to spike and tag in 5" Ash	found	5.75'
S 3 W	11.70'	to spike and tag in 7" Ash	found	11.62'
N 30 E	9.58'	to set P.K./tag #22445 in East face 10" Oak	found	9.52'
S 15 W	11.64'	to set P.K./tag #22445 in East face of 14" Elm	found	11.62'
S 50 E	13.94'	to set P.K./tag #22445 in West face of 12" Hickory	found	14.18'
N 60 W	5.71'	to set P.K./tag #22445 in South face of 8" Elm	found	5.75'

lp  
h

C. Description of monument for corner and accessories established to perpetuate locating the position of the corner:

K-11 Found DNR monument.

- WIT:
- N 25 E 9.42' Set nail w/tag #33138 6" Oak
  - N 70 E 24.22' Set nail w/tag #33138 12" Oak
  - South 10.65' Set nail w/tag #33138 10" Oak
  - S 55 E 14.16' Set nail w/tag #33138 8" Shag Bark Hickory

Signed by James E. Kovas Date 12/23/99

Surveyor's Michigan License No. 33138