

LAND CORNER RECORDATION CERTIFICATE 1997  
Filing Requirement of Act 74, Mich. P.A. 1970

LIBER 20945 PAGE 592  
\$7.00 MISC RECORDING  
\$2.00 REMONUMENTATION  
01/04/2000 07:37:46 A.M. RECEIPT# 342  
PAID RECORDED - OAKLAND COUNTY  
G. WILLIAM CANDELL, CLERK/REGISTER OF DEEDS

For corners in

Oakland Located In: Corner Code #  
(county)  
Holly Township  
1. Public Land Survey T 5N R 7E K-13  
T R  
T R  
T R  
2. Property Controlling S T R  
in Section S T R  
3. Miscellaneous S T R  
Property in Sec. S T R

REGISTER OF DEEDS  
OAKLAND COUNTY  
RECORDED 10-22-98 JS  
REGISTER OF DEEDS STAMP & FILE NUMBER

SECTION

4. Lot No. \_\_\_\_\_, Recorded Plat \_\_\_\_\_

5. Private Claims \_\_\_\_\_

	A	B	C	D	E	F	G	H	I	J	K
2	6	5	4	3	2						
3											
4	7	8	9	10	11						
5											
6	18	17	16	15	14						
7											
8	19	20	21	22	23						
9											
10	30	29	28	27	26						
11											
12	31	32	33	34	35						
13											

I, James E. Kovas, in a field survey on June 4, 1998, do hereby certify that under requirements of P.A. 74, Michigan P.A. of 1970, the corner points mentioned in lines 1 and 2 above were in conformance with regulations and rules therefore as required in the current manual of survey instructions of the United States Department of the Interior, Bureau of Land Management or by a decree of a Court of Law and/or that the corner points mentioned in lines 3, 4 and 5 above were in conformance with the rules of the Michigan Board of Land Surveyors or by a Decree of a Court of Law; established, re-established, monumented, re-monumented, recovered, found as expressed below:

NOTE: Not more than 4 corners, all in the same town and range, may be recorded on this certificate.

A. Description of original monument and accessories and/or subsequent restoration:

K-13  
1816 - G.L.O., Alex Holmes, D.S., set post  
1971 - John Albright #10057 (LCRC Liber 6373, Page 845) found 1/2" rerod  
1996 - Grant Ward #22445 (Survey Liber 17074, Page 844) no monument described

Distances: K-13 to L-13 = 2643.21' (Wade-Trim, 1998)  
K-13 to L-13 = 2643.28' (Ward, 1996)  
K-13 to J-13 = 2678.82' (Wade-Trim, 1999)  
K-13 to K-12 = 2645.19' (Wade-Trim, 1998)  
K-13 to K-12 = 2645.32' (Newman, 1992)  
K-13 to K-12 = 2658.08' (Ward, 1996)

B. Description of corner evidence found and/or method applied in restoring or reestablishing corner:

K-13 Found 1/2" iron.


WITNESSES FOUND:

S 50 E 40.55' to chiseled "x" in top 4' x 6' boulder found 40.30'  
S 10 E 29.23' to twin 6" Cherry (diff. nail) found 28.53'  
West 65.99' to NE corner Section 2 Rose Township found 66.00'  
South 28.55' to twin 8" Cherry found 28.53'  
S 85 E 42.47' to twin 8" Locust found 42.41'  
N 40 E 85.80' to Power Pole found 85.80'  
N 45 W 38.93' to 6" Hickory found 38.91'  
N 80 W 25.90' to Telephone Pole found 25.92'

C. Description of monument for corner and accessories established to perpetuate locating the position of the corner:

K-13 Found 1/2" iron (18" long). Removed and replaced with cap #33138.

WIT: N 25 W 39.33' Set 40d nail w/tag #33138 West face 10" Pine  
N 67 W 25.96' Set 40d nail w/tag #33138 South face telephone pole  
South 28.56' Set 40d nail w/tag #33138 West face Twin 12" Cherry  
S 77 E 42.53' Set 40d nail w/tag #33138  
S 65 E 40.30' "X" in 4' x 6' Rock

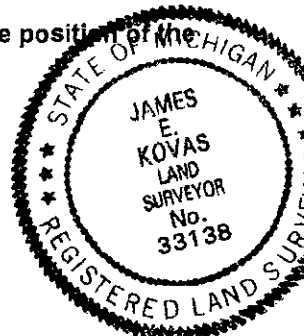

Signed by James E. Kovas

Date 12/22/99

Surveyor's Michigan License No. 33138