

LAND CORNER RECORDATION CERTIFICATE
Filing Requirement of Act 74, Mich. P.A. 1970

2000

For corners in

<u>Oakland</u> (county)	Located in:	Corner Code #
	Holly Township	
1. Public Land Survey	T <u>5N</u> R <u>7E</u>	<u>L-5</u>
	T _____ R _____	
	T _____ R _____	
	T _____ R _____	
2. Property Controlling in Section	S _____ T _____	
	S _____ T _____	
3. Miscellaneous Property in Sec.	S _____ T _____	
	S _____ T _____	

LIBER 20945 PAGE 595
\$7.00 MISC RECORDING
\$2.00 REINUMENTATION
01/04/2000 07:37:46 A.M. RECEIPT# 342
PAID RECORDED - OAKLAND COUNTY
G. WILLIAM CADDELL, CLERK/REGISTER OF DEEDS

REGISTERED
3-3-99 53
Register of Deeds Stamp & File Number

SECTION

4. Lot No. _____, Recorded Plat _____

5. Private Claims _____

	A	B	C	D	E	F	G	H	I	J	K
2	6		5		4		3		2		
3											
4	7		8		9		10		11		
5											
6	18		17		16		15		14		
7											
8	19		20		21		22		23		
9											
10	30		29		28		27		26		
11											
12	31		32		33		34		35		
13											

I, James E. Kovas, in a field survey on February 19, 1999, do hereby certify that under requirements of P.A. 74, Michigan P.A. of 1970, the corner points mentioned in lines 1 and 2 above were in conformance with regulations and rules therefore as required in the current manual of survey instructions of the United States Department of the Interior, Bureau of Land Management or by a decree of a Court of Law and/or that the corner points mentioned in lines 3, 4 and 5 above were in conformance with the rules of the Michigan Board of Land Surveyors or by a Decree of a Court of Law; established, re-established, monumented, re-monumented, recovered, found as expressed below:

NOTE: Not more than 4 corners, all in the same town and range, may be recorded on this certificate.

A. Description of original monument and accessories and/or subsequent restoration:

L-5
1816 - G.L.O., Alex Holmes, D.S., set post

Distances: L-5 to K-5 = 2691.82' (Wade-Trim, 1999)

L-5 to M-5 = 2700.03' (Wade-Trim, 1999)

B. Description of corner evidence found and/or method applied in restoring or reestablishing corner:


L-5 Found 1/2" iron in 1" iron pipe in fence.

No records were found for this corner. The iron found is positioned close to half way and on line between the adjacent section corners.

C. Description of monument for corner and accessories established to perpetuate locating the position of the corner:

L-5 Found 1/2" iron in 1" iron pipe on fence line West-South. Removed and replaced West concrete monument cap #33138.

WIT: N 66 E 3.59' Set P.K. nail w/tag #33138 6" Maple dead South face
S 70 E 9.74' Set P.K. nail w/tag #33138 fence post North face
S 62 W 19.83' Set P.K. nail w/tag #33138 6" Maple dead North face
N 30 W 58.30' Set P.K. nail w/tag #33138 8" Maple dead West face

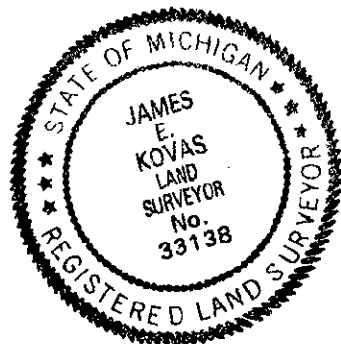

Signed by James E. Kovas

Date 12/22/99

Surveyor's Michigan License No. 33138