

LAND CORNER RECORDATION CERTIFICATE
Filing Requirement of Act 74, Mich. P.A. 1970

2001

For corners in

Oakland Located In: Corner Code #
(county)
1. Public Land Survey Holly Township
T. 5N R. 7E L-7
T. R.
T. R. SURVEY &
T. R. RE-ESTABLISHMENT
2. Property Controlling S. T. R.
in Section S. T. R.
3. Miscellaneous S. T. R. MAR 31 2000
Property in Sec. S. T. R.

LIBER 20945 PAGE 596
\$7.00 MISC RECORDING
\$2.00 REMONUMENTATION
01/04/2000 07:37:46 A.M. RECEIPT# 342
PAID RECORDED - OAKLAND COUNTY
S. WILLIAM CADDELL, CLERK/REGISTER OF DEED

5-12-99 JB
Register of Deeds Stamp & File Number

SECTION

4. Lot No. _____, Recorded Plat _____
5. Private Claims _____

	A	B	C	D	E	F	G	H	I	J	K
2	6	5	4	3	2						
3											
4	7	8	9	10	11						
5											
6	16	17	18	15	14						
7											
8	19	20	21	22	23						
9											
10	30	29	28	27	26						
11											
12	31	32	33	34	35						
13											

I, James E. Kovas, in a field survey on February 19, 1999, do hereby certify that under requirements of P.A. 74, Michigan P.A. of 1970, the corner points mentioned in lines 1 and 2 above were in conformance with regulations and rules therefore as required in the current manual of survey instructions of the United States Department of the Interior, Bureau of Land Management or by a decree of a Court of Law and/or that the corner points mentioned in lines 3, 4 and 5 above were in conformance with the rules of the Michigan Board of Land Surveyors or by a Decree of a Court of Law; established, re-established, monumented, re-monumented, recovered, found as expressed below:

NOTE: Not more than 4 corners, all in the same town and range, may be recorded on this certificate.

A. Description of original monument and accessories and/or subsequent restoration:

L-7
1816 - G.L.O., Alex Holmes, D.S., set post
1990 - Chris Newman #24607 (LCRC Liber 11604, Page 652) found 1/2" rerod

Distances: L-7 to K-7 = 2672.49' (Wade-Trim, 1999)
L-7 to M-7 = 2696.54' (Wade-Trim, 1999)

B. Description of corner evidence found and/or method applied in restoring or reestablishing corner:

L-7 Found 1/2" iron in 1" iron pipe in fence.

See letter dated April 23, 1999 from Chris Newman. Wade-Trim recommends that this corner, as found, be accepted.


WITNESSES FOUND:

S 10 E 17.70' to spike in 10" Oak found 17.75'
N 45 W 10.45' to spike in 15" Oak found 10.45'
N 30 E 23.92' to spike 12" Hickory found 23.89'

C. Description of monument for corner and accessories established to perpetuate locating the position of the corner:

L-7 Found 1/2" iron in fence line East-West. Removed and replaced w/concrete monument cap #33138.

WIT: N 50 W 10.45' Set P.K. nail w/tag #33138 16" Oak
N 56 E 23.93' Set P.K. nail w/tag #33138 6" Shag Bar Hickory
S 38 E 21.56' Set P.K. nail w/tag #33138 14" Oak
South 17.96' Set P.K. nail w/tag #33138 10" Oak

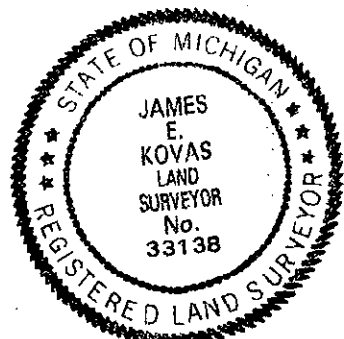

Signed by James E. Kovas Date 12/22/99

Surveyor's Michigan License No. 33138