

LAND CORNER RECORDATION CERTIFICATE
Filing Requirement of Act 74, Mich. P.A. 1970

2004

For corners in

Oakland Located In: Holly Township Corner Code # L-13
(county)
1. Public Land Survey T 5N R 7E L-13
T R SURVEY &
T R RE SECTION
2. Property Controlling S T R MAR 21 2000
in Section S T R
3. Miscellaneous S T R
Property in Sec. S T R SECTION

LIBER 20945 PAGE 599
\$7.00 MISC RECORDING
\$2.00 REMONUMENTATION
01/04/2000 07:37:46 A.M. RECEIPT# 342
PAID RECORDED - OAKLAND COUNTY
G. WILLIAM CADDELL, CLERK/REGISTER OF DEEDS

10-28-98 JS

Register of Deeds Stamp & File Number

4. Lot No. _____ Recorded Plat _____
5. Private Claims _____

I, James E. Kovas, in a field survey on June 4, 1998, do hereby certify that under requirements of P.A. 74, Michigan P.A. of 1970, the corner points mentioned in lines 1 and 2 above were in conformance with regulations and rules therefore as required in the current manual of survey instructions of the United States Department of the Interior, Bureau of Land Management or by a decree of a Court of Law and/or that the corner points mentioned in lines 3, 4 and 5 above were in conformance with the rules of the Michigan Board of Land Surveyors or by a Decree of a Court of Law; established, re-established, monumented, re-monumented, recovered, found as expressed below:

	A	B	C	D	E	F	G	H	I	J	K	L
2	6	5	4	3	2							
3												
4	7	8	9	10	11							
5												
6	18	17	16	15	14							
7												
8	19	20	21	22	23							
9												
10	30	29	28	27	26							
11												
12	31	32	33	34	35							
13												

NOTE: Not more than 4 corners, all in the same town and range, may be recorded on this certificate.

A. Description of original monument and accessories and/or subsequent restoration:
L-13
1816 - G.L.O., Alex Holmes, D.S., set post
1971 - John Albright #10057 (LCRC Liber 7455, Page 862) found 5/8" rerod
1996 - Grant Ward #22445 (Survey Liber 17074, Page 844) no monument described

Distances: L-13 to K-13 = 2643.21' (Wade-Trim, 1998)
L-13 to K-13 = 2643.28' (Ward, 1997)
L-13 to M-13 = 2643.30' (Wade-Trim, 1998)
L-13 to M-13 = 2643.44' (Ward, 1997)

B. Description of corner evidence found and/or method applied in restoring or reestablishing corner:
L-13 Found 3/4" iron rod.

WITNESSES FOUND:


S 50 E	46.55'	to 36" Oak	(diff. Nail)	found	45.90'
S 5 W	28.65'	to 10" Oak	(diff nail)	found	29.03'
N 45 W	25.65'	to 6" Hickory		found	25.80'
S 11 W	29.02'	to 14" Oak		found	29.03'
N 45 W	25.77'	to 6" Hickory		found	25.80'
S 51 E	46.03'	to 42" Oak		found	45.90'

lp
R

C. Description of monument for corner and accessories established to perpetuate locating the position of the corner:

L-13 Found 3/4" iron rod (2' long). Removed and replaced with 5/8" iron cap #33138.

WIT: N 48 W 25.65' Set 40d nail w/tag #33138 SW face 6" Hickory
N 15 E 31.45' Set 40d nail w/tag #33138 South face 36" Oak
S 51 E 45.87' Set 40d nail w/tag #33138 North face 42" Oak
S 11 W 28.95' Set 40d nail w/tag #33138 East face 14" Oak

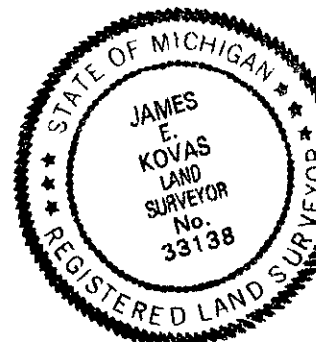

Signed by James E. Kovas Date 12/22/99

Surveyor's Michigan License No. 33138