

LAND CORNER RECORDATION CERTIFICATE
Filing Requirement of Act 74, Mich. P.A. 1970

For corners in

Oakland Located in: Holly Township Corner Code # M-1
(county)
1. Public Land Survey T 5N R 7E _____
T _____ R _____
T _____ R _____
T _____ R _____
2. Property Controlling S _____ T _____ R _____
in Section S _____ T _____ R _____
3. Miscellaneous S _____ T _____ R _____
Property in Sec. S _____ T _____ R _____

2005
LIBER 20945 PAGE 600
\$7.00 MISC RECORDING
\$2.00 REMONUMENTATION
01/04/2000 07:37:46 A.M. RECEIPT# 342
PAID RECORDED - OAKLAND COUNTY
G. WILLIAM CADDELL, CLERK/REGISTER OF DEEDS
APPROVED BY: 1-3-99 Jr
OAKLAND COUNTY REGISTER OF DEEDS
Register of Deeds Stamp & File Number

4. Lot No. _____, Recorded Plat _____ SECTION _____
5. Private Claims _____

I, James E. Kovas, in a field survey on 6-4, 1998, do hereby certify that under requirements of P.A. 74, Michigan P.A. of 1970, the corner points mentioned in lines 1 and 2 above were in conformance with regulations and rules therefore as required in the current manual of survey instructions of the United States Department of the Interior, Bureau of Land Management or by a decree of a Court of Law and/or that the corner points mentioned in lines 3, 4 and 5 above were in conformance with the rules of the Michigan Board of Land Surveyors or by a Decree of a Court of Law; established, re-established, monumented, re-monumented, recovered, found as expressed below:

	A	B	C	D	E	F	G	H	I	J	K	L
2		6		5		4		3		2		1
3												
4		7		8		9		10		11		12
5												
6		16		17		18		15		14		13
7												
8		19		20		21		22		23		24
9												
10		30		29		28		27		26		25
11												
12		31		32		33		34		35		36
13												

NOTE: Not more than 4 corners, all in the same town and range, may be recorded on this certificate.


A. Description of original monument and accessories and/or subsequent restoration:
M-1
1816 - G.L.O., Alex Holmes, D.S., set post
1962 - County Road Commission Records (Stone)
1973 - Karol Piotrowski #9685 (LCRC Liber 6203, Page 430) found 1" pipe in existing centerline

Distances: M-1 to M-2 = 3143.30' (Wade-Trim, 1998)
M-1 to M-2 = 3143.26' (Piotrowski, 1973)
M-1 to L-1 = 2691.98' (Wade-Trim, 1998)
M-1 to L-1 = 2691.64' (Piotrowski, 1973)
M-1 to A-2 (Groveland) = 2607.61' (Wade-Trim, 1998)
M-1 to A-2 (Groveland) = 2607.97' (Piotrowski, 1973)

B. Description of corner evidence found and/or method applied in restoring or reestablishing corner:
M-1 Found Iron with cap.

WITNESSES FOUND:

East	133.20'	to 30" White Oak	found	136.00'	to center
SE	70.60'	to 30" West Oak	found	69.20'	to face
West	43.70'	to 8" Twin Oak	found	40'	center
S 25 E	71.95'	to 40" Oak	found	71.15'	face
West	50.00'	to Gould T-bar	found	50.02'	

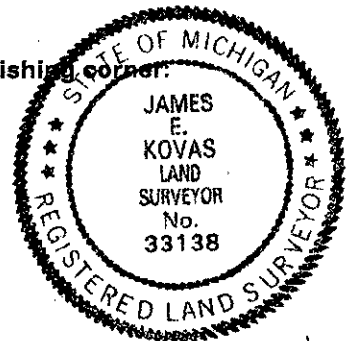

C. Description of monument for corner and accessories established to perpetuate locating the position of the corner:

M-1 Found Iron with remon cap verified following witnesses.

WIT: West 22.66' Found mag nail and remon tag in North face 8" Oak
N 30 W 53.89' Found mag nail and remon tag in East face Power Pole
East 20.01' Set mag nail and remon tag in North face 8" Poplar
S 40 E 25.65' Found mag nail and remon tag in SW face 30" Oak

Signed by James Kovas Date 12/23/99