

LAND CORNER RECORDATION CERTIFICATE  
Filing Requirement of Act 74, Mich. P.A. 1970

2006

LIBER 20945 PAGE 601  
\$7.00 MISC RECORDING  
\$2.00 REMONUMENTATION  
01/04/2000 07:37:46 A.M. RECEIPT# 342  
PAID RECORDED - OAKLAND COUNTY  
G. WILLIAM CADDELL, CLERK/REGISTER OF I

APR 11 2000  
1-5-99 JS  
REGISTER OF DEEDS

Register of Deeds Stamp & File Number

For corners in

Oakland Located In: Corner Code #  
(county)  
Holly Township  
1. Public Land Survey T 5N R 7E M-2  
T R  
T R SURVEY &  
T R RE-ESTABLISHMENT  
2. Property Controlling S T R  
in Section S T R MAR 21 2000  
3. Miscellaneous S T R  
Property in Sec. S T R  
SECTION

4. Lot No. \_\_\_\_\_, Recorded Plat \_\_\_\_\_  
5. Private Claims \_\_\_\_\_

I, James E. Kovas, in a field survey on August 25, 1998, do hereby certify that under requirements of P.A. 74, Michigan P.A. of 1970, the corner points mentioned in lines 1 and 2 above were in conformance with regulations and rules therefore as required in the current manual of survey instructions of the United States Department of the Interior, Bureau of Land Management or by a decree of a Court of Law and/or that the corner points mentioned in lines 3, 4 and 5 above were in conformance with the rules of the Michigan Board of Land Surveyors or by a Decree of a Court of Law; established, re-established, monumented, re-monumented, recovered, found as expressed below:

NOTE: Not more than 4 corners, all in the same town and range, may be recorded on this certificate.

A. Description of original monument and accessories and/or subsequent restoration:  
M-2

- 1816 - G.L.O., Alex Holmes, D.S., set post
- 1962 - County Road Commission Records (Stone)
- 1973 - Karol Piotrowski #9685 (LCRC Liber 6203, Page 430) set rered at extension to 1/4 line fence and centerline of road

Distances: M-2 to M-1 = 3143.30' (Wade-Trim, 1998)  
M-2 to M-1 = 3143.26' (Piotrowski, 1973)  
M-2 to A-2 (Groveland) = 535.70' (Wade-Trim, 1998)  
M-2 to A-2 (Groveland) = 535.29' (Piotrowski, 1973)  
M-2 to M-3 = 2644.83' (Wade-Trim, 1998)

B. Description of corner evidence found and/or method applied in restoring or reestablishing corner:

M-2 Found iron.  
West 32.97' to found 1/2" iron w/Delta cap.

WITNESSES FOUND:


West 26.00' to fence post found broken 28.00'  
N 25 E 66.74' to 24" Oak found 66.67'

C. Description of monument for corner and accessories established to perpetuate locating the position of the corner:

M-2 Found 1/2" iron replaced with remon capped iron

WIT: N 50 E 28.10' Set remon tag #33138 in NW face 8" Oak  
S 70 E 20.55' Set remon tag #33138 in SW face 18" Oak  
S 50 W 15.87' Set remon tag #33138 in SE face 12" Oak  
N 80 W 22.71' Set remon tag #33138 in S face 10" Oak  
North 535.69' Found remon capped (#33136) iron, A-2 Groveland Township

	A	B	C	D	E	F	G	H	I	J	K	L
2	6		5		4		3		2			
3												
4	7		8		9		10		11			
5												
6	18		17		16		15		14			
7												
8	19		20		21		22		23			
9												
10	30		29		28		27		26			
11												
12	31		32		33		34		35			
13												

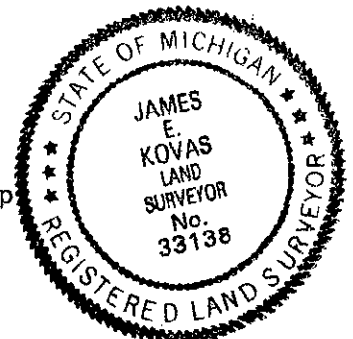

Signed by James E. Kovas

Date 12/22/99

Surveyor's Michigan License No. 33138