

LAND CORNER RECORDATION CERTIFICATE
Filing Requirement of Act 74, Mich. P.A. 1970

LIBER 20945 PAGE 602
\$7.00 MISC RECORDING
\$2.00 RE-MONUMENTATION
01/04/2000 07:37:46 A.M. RECEIPT# 342
PAID RECORDED - OAKLAND COUNTY
G. WILLIAM CADDELL, CLERK/REGISTER OF DEEDS

For corners in

Oakland Located In: _____ Corner Code # _____
(county)
1. Public Land Survey Holly Township
T 5N R 7E _____ M-3
T _____ R _____ SURVEY &
T _____ R _____ RE-MONUMENTATION
2. Property Controlling S _____ T _____
In Section S _____ T _____ MAR 21 2000
3. Miscellaneous S _____ T _____
Property in Sec. S _____ T _____
SECTION

Register of Deeds Stamp & File Number
1-3-99 JS

4. Lot No. _____, Recorded Plat _____
5. Private Claims _____

	A	B	C	D	E	F	G	H	I	J	K	L
2	6	5	4	3	2							
3												
4	7	8	9	10	11							
5												
6	16	17	18	15	14							
7												
8	19	20	21	22	23							
9												
10	30	29	28	27	26							
11												
12	31	32	33	34	35							
13												

I, James E. Kovas, in a field survey on November 29, 1998, do hereby certify that under requirements of P.A. 74, Michigan P.A. of 1970, the corner points mentioned in lines 1 and 2 above were in conformance with regulations and rules therefore as required in the current manual of survey instructions of the United States Department of the Interior, Bureau of Land Management or by a decree of a Court of Law and/or that the corner points mentioned in lines 3, 4 and 5 above were in conformance with the rules of the Michigan Board of Land Surveyors or by a Decree of a Court of Law; established, re-established, monumented, re-monumented, recovered, found as expressed below:

NOTE: Not more than 4 corners, all in the same town and range, may be recorded on this certificate.

A. Description of original monument and accessories and/or subsequent restoration:
M-3
1816 - G.L.O., Alex Holmes, D.S., set post
1940 - ME Baldwin, Holly Acres (Book 34, Page 26) no monument described


Distances: M-3 to L-3 = 2723.84' (Wade-Trim, 1999)
M-3 to L-3 = 2726.17' (Baldwin, 1940)
M-3 to M-2 = 2644.83' (Wade-Trim, 1998)
M-3 to A-3 = (Groveland) 575.05' north (Wade-Trim/Kieft, 1998)
M-3 to M-4 = 2649.31' (Wade-Trim, 1998)
M-3 to M-4 = 2649.66' (Baldwin survey, 1940)

B. Description of corner evidence found and/or method applied in restoring or reestablishing corner:

M-3 Found iron with Albright cap.
No witnesses found.
Iron agrees very well with Baldwin distance to M-4.
Found iron at NE corner Lot 23, Holly Acres 15.00' South (M) and (R).
Found iron at NE corner Lot 24, Holly Acres 406.00' West (M), 406.17' (R).

C. Description of monument for corner and accessories established to perpetuate locating the position of the corner:

M-3 Found 1/2" iron w/cap. Removed and replaced with concrete monument cap #33138.
WIT: N 40 W 20.75' Set nail w/tag #33138 10" Oak
S 64 W 34.33' Set nail w/tag #33138 10" Oak
S 14 W 22.27' Set nail w/tag #33138 6" Oak
S 42 E 51.75' Set nail w/tag #33138 in 8" Poplar
Found 15' South wood stake no iron

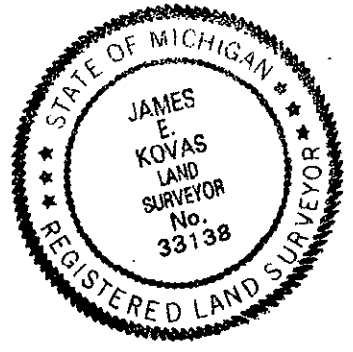

Signed by James E. Kovas Date 12/24/99