

LAND CORNER RECORDATION CERTIFICATE  
Filing Requirement of Act 74, Mich. P.A. 1970

2009

For corners in

LIBER 20945 PAGE 604  
\$7.00 MISC RECORDING  
\$2.00 REMONUMENTATION  
01/04/2000 07:37:46 A.M. RECEIPT# 342  
PAID RECORDED - OAKLAND COUNTY  
G. WILLIAM CADDELL, CLERK/REGISTER OF DEEDS  
ACT 74, P.A. 1970

Oakland Located In: Corner Code #  
(county)  
1. Public Land Survey T 5N R 7E M-5  
T R  
T R  
T R  
2. Property Controlling S T  
in Section S T  
3. Miscellaneous S T  
Property in Sec. S T

MADE ON: 3-3-99 JS  
RECORDED BY: [unclear]

Register of Deeds Stamp & File Number

SECTION

4. Lot No. \_\_\_\_\_, Recorded Plat \_\_\_\_\_  
5. Private Claims \_\_\_\_\_

	A	B	C	D	E	F	G	H	I	J	K	L
2	6	5	4	3	2							
3												
4	7	8	9	10	11							
5												
6	18	17	16	15	14							
7												
8	19	20	21	22	23							
9												
10	30	29	28	27	26							
11												
12	31	32	33	34	35							
13												

I, James E. Kovas, in a field survey on November 3, 1998, do hereby certify that under requirements of P.A. 74, Michigan P.A. of 1970, the corner points mentioned in lines 1 and 2 above were in conformance with regulations and rules therefore as required in the current manual of survey instructions of the United States Department of the Interior, Bureau of Land Management or by a decree of a Court of Law and/or that the corner points mentioned in lines 3, 4 and 5 above were in conformance with the rules of the Michigan Board of Land Surveyors or by a Decree of a Court of Law; established, re-established, monumented, re-monumented, recovered, found as expressed below:

NOTE: Not more than 4 corners, all in the same town and range, may be recorded on this certificate.

A. Description of original monument and accessories and/or subsequent restoration:

M-5  
1816 - G.L.O., Alex Holmes, D.S., set post  
1932 - ME Baldwin (Book 34, Page 16) I.P.  
1974 - James Schari #19843 (LCRC Liber 7177, Page 588 and Survey liber 6299, Page 585) found 3/4" iron

Distances: M-5 to L-3 = 2700.03' (Wade-Trim, 1999)  
M-5 to M-4 = 2589.18' (Wade-Trim, 1998)  
M-5 to M-6 = 2657.09' (Wade-Trim, 1998)

B. Description of corner evidence found and/or method applied in restoring or reestablishing corner:

M-5 Found 2" Iron pipe.

WITNESSES FOUND


North 81.00' to edge of Horton Lake found 80' +/-  
N 25 E 38.60' to nail in east side 6" Maple found 40.33'  
S 86 E 18.98' to nail in North side 6" Maple found 20.29'  
South 26.40' to nail in east side 8" Maple found 25.63'

C. Description of monument for corner and accessories established to perpetuate locating the position of the corner:

M-5 Found 2" iron pipe. Removed and replaced with concrete monument cap #33138.

WIT: North 11.75' Set P.K. nail w/tag #33138 6" Shag Bark East face  
East 20.26' Set P.K. nail w/tag #33138 6" Maple North face  
S 5 E 25.59' Set P.K. nail w/tag #33138 16" Oak East face  
N 28 W 22.21' Set P.K. nail w/tag #33138 6" Maple South face

NOTE: Witness check fell within .15

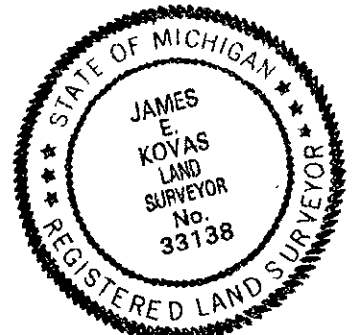

Signed by James E. Kovas Date 12/22/99

Surveyor's Michigan License No. 33138