

LAND CORNER RECORDATION CERTIFICATE
Filing Requirement of Act 74, Mich. P.A. 1970

2010

For corners in

Oakland Located in: Holly Township Corner Code # _____
(county)

1. Public Land Survey T 5N R 7E M-6
T _____ R _____
T _____ R _____
T _____ R _____

2. Property Controlling S _____ T _____ R _____
in Section S _____ T _____ R _____

3. Miscellaneous S _____ T _____ R _____
Property in Sec. S _____ T _____ R _____

LIBER 20945 PAGE 605
\$7.00 MISC RECORDING
\$2.00 REMONUMENTATION
01/04/2000 07:37:45 A.M. RECEIPT# 342
PAID RECORDED - OAKLAND COUNTY
G. WILLIAM CADDELL, CLERK/REGISTER OF DEEDS

County of Oakland
Act 74, P.A. 1970
REMOVED on 3-3-99 JS
OAKLAND COUNTY REGISTER OF DEEDS
Register of Deeds Stamp & File Number

4. Lot No. _____, Recorded Plat _____ SECTION _____

5. Private Claims _____

I, James E. Kovas, in a field survey on November 3, 1998, do hereby certify that under requirements of P.A. 74, Michigan P.A. of 1970, the corner points mentioned in lines 1 and 2 above were in conformance with regulations and rules therefore as required in the current manual of survey instructions of the United States Department of the Interior, Bureau of Land Management or by a decree of a Court of Law and/or that the corner points mentioned in lines 3, 4 and 5 above were in conformance with the rules of the Michigan Board of Land Surveyors or by a Decree of a Court of Law; established, re-established, monumented, re-monumented, recovered, found as expressed below:

	A	B	C	D	E	F	G	H	I	J	K	L
2	6	5	4	3	2							
3												
4	7	8	9	10	11							
5												
6	13	17	16	15	14							
7												
8	19	20	21	22	23							
9												
10	30	29	28	27	26							
11												
12	31	32	33	34	35							
13												

NOTE: Not more than 4 corners, all in the same town and range, may be recorded on this certificate.

A. Description of original monument and accessories and/or subsequent restoration:
M-6
1816 - G.L.O., Alex Holmes, D.S., set post

Distances: M-6 to M-5 = 2657.09' (Wade-Trim, 1998)
M-6 to M-7 = 2590.44' (Wade-Trim, 1998)
M-6 to A-6 = (Groveland) 582.36' (Wade-Trim/Kieft, 1998)

B. Description of corner evidence found and/or method applied in restoring or reestablishing corner:
M-6 Found 1" iron pipe on top of large rock.

Wade-Trim found a 1/2" property iron as shown on the tax maps to the West of the found 1" iron pipe on top of a large rock. 431.16' (M) 431.31' (R)


The following witnesses were found near the 1" iron pipe with no record to compare with:

WITNESSES FOUND
N 58 W 34.10' to 10" Elm
N 80 E 37.36' to 12" Elm
S 8 W 49.28' to 28" Oak

C. Description of monument for corner and accessories established to perpetuate locating the position of the corner:

M-6 Found 1" iron pipe. Large rock on bottom. Removed and replaced with concrete monument. No cap.

WIT: N 58 W 33.80' Set nail w/tag #33138 10" Elm
N 79 E 37.35' Set nail w/tag #33138 12" Elm
S 8 W 49.11' Set nail w/tag #33138 28" Oak
N 42 E 33.79' Set nail w/tag #33138 10" Hickory

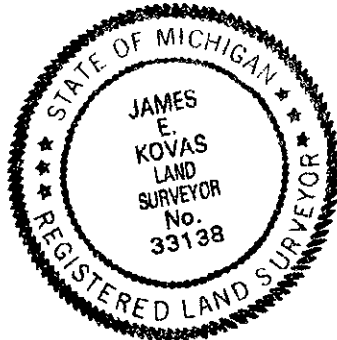

Signed by James E. Kovas Date 12/22/99

Surveyor's Michigan License No. 33138