

LAND CORNER RECORDATION CERTIFICATE
Filing Requirement of Act 74, Mich. P.A. 1970

2012

For corners in

Form with fields for County (Oakland), Township (Holly), Range (7E), and Section (M-8). Includes checkboxes for Public Land Survey, Property Controlling in Section, and Miscellaneous Property in Sec.

LIBER 20945 PAGE 607
\$7.00 MISC RECORDING
\$2.00 REMONUMENTATION
01/04/2000 07:37:46 A.M. RECEIPT# 342
PAID RECORDED - OAKLAND COUNTY
G. WILLIAM CADDELL, CLERK/REGISTER OF DEEDS

Register of Deeds Stamp & File Number

SECTION

4. Lot No. , Recorded Plat
5. Private Claims

I, James E. Kovas, in a field survey on December 16, 1999, do hereby certify that under requirements of P.A. 74, Michigan P.A. of 1970, the corner points mentioned in lines 1 and 2 above were in conformance with regulations and rules therefore as required in the current manual of survey instructions of the United States Department of the Interior, Bureau of Land Management or by a decree of a Court of Law and/or that the corner points mentioned in lines 3, 4 and 5 above were in conformance with the rules of the Michigan Board of Land Surveyors or by a Decree of a Court of Law; established, re-established, monumented, re-monumented, recovered, found as expressed below:

NOTE: Not more than 4 corners, all in the same town and range, may be recorded on this certificate.

A. Description of original monument and accessories and/or subsequent restoration:

M-8
1816 - G.L.O., Alex Holmes, D.S., set post

Distances: M-8 to M-7 = 2590.44' (Wade-Trim, 1998)
M-8 to M-9 = 2590.44' (Wade-Trim, 1998)

B. Description of corner evidence found and/or method applied in restoring or reestablishing corner:

M-8 No corner found. Corner is in a gravel pit at Mt. Holly.


The corners M-8 and M-7 fall within the gravel pit. No evidence was found of the corners. The corners were computed by using 1/3 of the distance between M-6 and M-9. M-7 was placed on a line projected through M-6 and A-7 since A-7 is the best evidence of the original location of the Township line at M-7. M-8 as placed on line between the computed M-7 position and M-9.

C. Description of monument for corner and accessories established to perpetuate locating the position of the corner:

M-8 Set 5/8" w/cap #33138 in gravel pit.

WIT: N 60 W Over 100' to 6" Maple
S 50 W 60.00' To 8"-10" Poplar
S 10 W At 78' to 8-10" Elm
S 60 W P.K. Set 6" Poplar

Grid table with columns A-L and rows 2-13. Contains numbers 6 through 35 in a grid pattern.

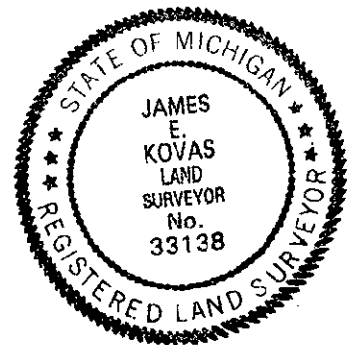

lp
R

Signed by James E. Kovas Date 12/23/99

Surveyor's Michigan License No. 33138