

LAND CORNER RECORDATION CERTIFICATE
Filing Requirement of Act 74, Mich. P.A. 1970

2014

For corners in

Oakland Located In: Corner Code #
(county)
1. Public Land Survey T 5N R 7E M-10
T R
T R
T R
2. Property Controlling S T R
in Section S T R
3. Miscellaneous S T R
Property in Sec. S T R

LIBER 20945 PAGE 609
\$7.00 MISC RECORDING
\$2.00 REMONUMENTATION
01/04/2000 07:37:46 A.M. RECEIPT# 342
PAID RECORDED - OAKLAND COUNTY
G. WILLIAM CADDELL, CLERK/REGISTER OF DEEDS

Register of Deeds Stamp & File Number

2-3-99 JS

SECTION

	A	B	C	D	E	F	G	H	I	J	K	L
2	6		5		4		3		2			
3												
4	7		8		9		10		11			
5												
6	16		17		18		19		20			
7												
8	19		20		21		22		23			
9												
10	30		29		28		27		26			
11												
12	31		32		33		34		35			
13												

I, James E. Kovas, in a field survey on December 11, 1998, do hereby certify that under requirements of P.A. 74, Michigan P.A. of 1970, the corner points mentioned in lines 1 and 2 above were in conformance with regulations and rules therefore as required in the current manual of survey instructions of the United States Department of the Interior, Bureau of Land Management or by a decree of a Court of Law and/or that the corner points mentioned in lines 3, 4 and 5 above were in conformance with the rules of the Michigan Board of Land Surveyors or by a Decree of a Court of Law; established, re-established, monumented, re-monumented, recovered, found as expressed below:

NOTE: Not more than 4 corners, all in the same town and range, may be recorded on this certificate.

A. Description of original monument and accessories and/or subsequent restoration:

- M-10 1816 - G.L.O., Alex Holmes, D.S., set post
- 1962 - Oakland County Road Commission (second ties) found 1/2" pipe with stones around it
- 1984 - Donald Bissell #18655 (LCRC Liber 8839, Page 261) found 1/2" rered with stones around it with MDOT witnesses.

Distances: M-10 to M-9 = 2617.07' (Wade-Trim, 1998)
M-10 to M-11 = 2457.47' (Wade-Trim, 1998)
M-10 to A-10 = (Groveland) 394.98' north (Wade-Trim/Kieft, 1998)

B. Description of corner evidence found and/or method applied in restoring or reestablishing corner:

M-10 Found 3" DNR monument in swamp, old fence north-south and west. Kieft Engineering also found this corner while establishing A-10 for Groveland Township.


WITNESSES FOUND:

SW 8.11" to 12" Maple found 9.06'
N 38 W 9.03' to 6" Ash found 9.06'
S 65 E 9.45' to 8" Elm found 9.45'
S 5 E 21.94' to 5" Ash found 21.99'

C. Description of monument for corner and accessories established to perpetuate locating the position of the corner:

M-10 Found DNR monument on fence line in swamp.

WIT: N 24 W 26.07' Set nail w/tag #33138 6" Elm
N 50 E 90.18' Set nail w/tag #33138 18" Elm
South 21.83' Set nail w/tag #33138 6" Elm
S 60 E 9.35' Set nail w/tag #33138 8" Elm

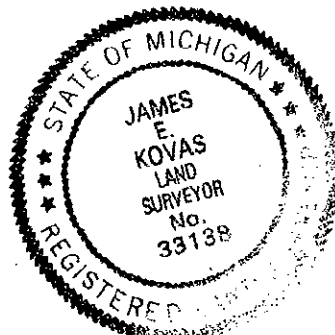

Signed by James E. Kovas Date 12/22/99

Surveyor's Michigan License No. 33138