

LAND CORNER RECORDATION CERTIFICATE
Filing Requirement of Act 74, Mich. P.A. 1970

2015

For corners in

Oakland Located In: Holly Township Corner Code # M-11
(county)

1. Public Land Survey T 5N R 7E _____
T _____ R _____
T _____ R _____
T _____ R _____

2. Property Controlling S _____ T _____ R _____
in Section S _____ T _____ R _____

3. Miscellaneous S _____ T _____ R _____
Property in Sec. S _____ T _____ R _____

LIBER 20945 PAGE 610
\$7.00 MISC RECORDING
\$2.00 REMONUMENTATION
01/04/2000 07:37:46 A.M. RECEIPT# 342
PAID RECORDED - OAKLAND COUNTY
G. WILLIAM CADDELL, CLERK/REGISTER OF DEEDS

NOT RECORDED
1/4/2000

REGISTERED OF: 3-3-99 JS
OAKLAND COUNTY PERMANENTLY
PLANNING GROUP COMMITTEE
Register of Deeds Stamp & File Number

SECTION

4. Lot No. _____, Recorded Plat _____

5. Private Claims _____

I, James E. Kovas, in a field survey on February 2, 1999, do hereby certify that under requirements of P.A. 74, Michigan P.A. of 1970, the corner points mentioned in lines 1 and 2 above were in conformance with regulations and rules therefore as required in the current manual of survey instructions of the United States Department of the Interior, Bureau of Land Management or by a decree of a Court of Law and/or that the corner points mentioned in lines 3, 4 and 5 above were in conformance with the rules of the Michigan Board of Land Surveyors or by a Decree of a Court of Law; established, re-established, monumented, re-monumented, recovered, found as expressed below:

	A	B	C	D	E	F	G	H	I	J	K	L
2	6		5		4		3		2			
3												
4	7		8		9		10		11			
5												
6	13		17		18		15		14			
7												
8	19		20		21		22		23			
9												
10	30		29		28		27		26			
11												
12	31		32		33		34		35			
13												

NOTE: Not more than 4 corners, all in the same town and range, may be recorded on this certificate.

A. Description of original monument and accessories and/or subsequent restoration:

M-11
1816 - G.L.O., Alex Holmes, D.S., set post
1984 - Donald Bissell #18655 (LCRC Liber 8839, Page 261) set 4" x 36" concrete monument with cap on North-South fenceline and extension of fence from west.

Distances: M-11 to M-10 = 2457.47' (Wade-Trim, 1998)
M-11 to M-12 = 2658.37' (Wade-Trim, 1998)
M-11 to A-11 = (Groveland) 252.61' North (Wade-Trim/Kieft, 1998)
M-11 to L-11 = 2663.81' (Wade-Trim, 1998)

B. Description of corner evidence found and/or method applied in restoring or reestablishing corner:


M-11 Found 4" x 36" concrete DNR monument with cap on North-South fence.
Kieft Engineering also found this corner while establishing A-10 for Groveland Township

WITNESSES FOUND:

N 78 E 33.43' to 7" Cherry found 33.45'
N 3 E 59.05' to 22" Cherry found 59.03'
N 23 E 16.65' to 16" Cherry found 16.64'

C. Description of monument for corner and accessories established to perpetuate locating the position of the corner:

M-11 Found DNR monument in tree line.
WIT: S 28 E 33.44' Set P.K. nail w/tag #33138 14" Cherry
S 70 E 39.10' Set P.K. nail w/tag #33138 10" Cherry Quad
N 21 E 16.64' Set P.K. nail w/tag #33138 22" Cherry
North 46.20' Set P.K. nail w/tag #33138 16" Cherry

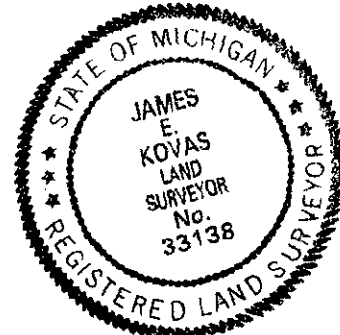

Signed by James E. Kovas Date 12/22/99