

LAND CORNER RECORDATION CERTIFICATE  
Filing Requirement of Act 74, Mich. P.A. 1970

2017

For corners in

<u>Oakland</u> (county)	Located In:	Corner Code #
	Holly Township	
1. Public Land Survey	T <u>5N</u> R <u>7E</u>	<u>M-13</u>
	T ___ R ___	___
	T ___ R ___	___
	T ___ R ___	___
2. Property Controlling in Section	S ___ T ___ R ___	___
	S ___ T ___ R ___	___
3. Miscellaneous Property in Sec.	S ___ T ___ R ___	___
	S ___ T ___ R ___	___

LIBER 20945 PAGE 612  
\$7.00 MISC RECORDING  
\$2.00 REMONUMENTATION  
01/04/2000 07:37:46 A.M. RECEIPT# 342  
PAID RECORDED - OAKLAND COUNTY  
G. WILLIAM CADDELL, CLERK/REGISTER OF DEEDS

Register of Deeds Stamp & File Number

4. Lot No. \_\_\_\_\_, Recorded Plat \_\_\_\_\_ SECTION \_\_\_\_\_

5. Private Claims \_\_\_\_\_

	A	B	C	D	E	F	G	H	I	J	K	L
2	6	5	4	3	2	1						
3												
4	7	3	9	10	11	1						
5												
6	18	17	16	15	14	13						
7												
8	19	20	21	22	23	24						
9												
10	30	29	28	27	26	25						
11												
12	31	32	33	34	35	36						
13												

I, James E. Kovas, in a field survey on June 4, 1998, do hereby certify that under requirements of P.A. 74, Michigan P.A. of 1970, the corner points mentioned in lines 1 and 2 above were in conformance with regulations and rules therefore as required in the current manual of survey instructions of the United States Department of the Interior, Bureau of Land Management or by a decree of a Court of Law and/or that the corner points mentioned in lines 3, 4 and 5 above were in conformance with the rules of the Michigan Board of Land Surveyors or by a Decree of a Court of Law; established, re-established, monumented, re-monumented, recovered, found as expressed below:

NOTE: Not more than 4 corners, all in the same town and range, may be recorded on this certificate.


A. Description of original monument and accessories and/or subsequent restoration:  
M-13  
1816 - G.L.O., Alex Holmes, D.S., set post  
1984 - Donald Bissell #18655 (LCRC Liber 8839, Page 265) found 1" pipe  
1996 - Grant Ward #22445 (LCRC Liber 17074, Page 844) no monument described

Distances: M-13 to L-13 = 2643.30' (Wade-Trim, 1998)  
M-13 to L-13 = 2643.44' (Ward, 1997)  
  
M-13 to M-12 = 2649.47' (Wade-Trim/Kieft, 1998)  
M-13 to M-12 = 2649.36' (Ward, 1997)

B. Description of corner evidence found and/or method applied in restoring or reestablishing corner:  
M-13 Found iron with remon cap #22443.

WITNESSES FOUND:

N 13 W 80.00'	to 14" Hickory	found	79.97'
N 58 E 53.83'	to 14" Cherry	found	53.82'
S 47 E 41.48'	to 36" Hickory	found	41.46'
S 46 W 42.18'	to 32" Hickory	found	41.78'
N 62 E 53.83'	to 14" Cherry	found	53.82'
S 62 E 41.35'	to 36" Hickory	found	41.46'
S 54 W 41.76'	to 36" Hickory	found	41.78'
N 11 W 80.06'	to 14" Hickory	found	79.97'

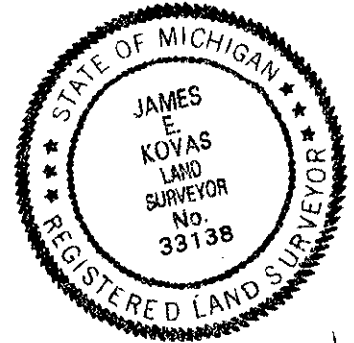

C. Description of monument for corner and accessories established to perpetuate locating the position of the corner:

M-13 Found iron with remon cap verified witnesses.

WIT: N 13 W 79.97' Tag #22443 14" Hickory  
N 58 E 53.82' Tag #22443 14" Cherry  
S 47 E 41.46' Tag #22443 36" Hickory  
S 46 W 41.78' Tag #22443 32" Hickory

Signed by James E. Kovas Date 12/23/99

Surveyor's Michigan License No. 33138