

STATE OF MICHIGAN
DEPARTMENT
OF
NATURAL RESOURCES

LAND CORNER RECORD


OAKLAND COUNTY
T 5 N R 8 E

DESCRIPTION OF CORNER SEC. COR. COMMON TO SEC. 4, 5, 8, & 9

CORNER MONUMENT 1" PIPE (3" BELOW GRADE)

DATE MONUMENT PLACED AND WITNESSED 7/10/62

WITNESSES TO CORNER..... N 64°W 17.4' 30" ELM

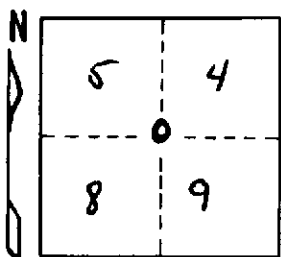


N 23°E 41.3' 26" ELM

S 0°E 43.9' 14" HICKERY

AND

CIRCLE CORNER REGISTERED

DESCRIPTION IN DETAIL AS TO HOW CORNER WAS LOCATED AND IDENTIFIED OR RESTORED.

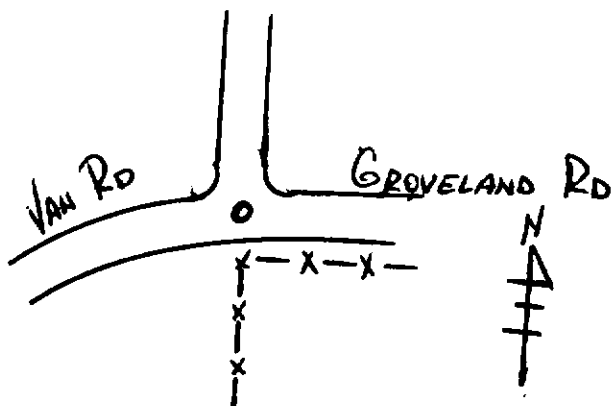

THIS CORNER RECOVERED &
REWITNESSED. PK NAILS & STAMPED
BRASS TAGS #12029

SURVEYOR'S SEAL

SIGNED

[Signature]
REGISTERED LAND SURVEYOR

DATE

7/22/62

DISTRIBUTION:

County Courthouse
Area Forester (Regions I & II)
District or Region Surveyor
Forestry Div., Lansing