


T. 5 N R. 8 E Groveland Twp. Oakland Co. Mich. SEC. 19

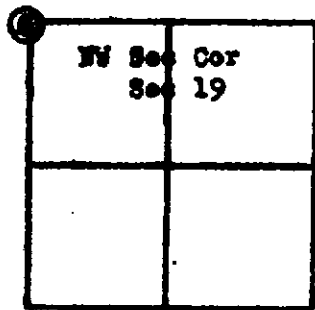

REMARKS


1/2" Dia Pipe In Fence Corner

MSHD Jan 14, 1959

WITNESSES


North 46.59 20" Oak
 S 20° W 13.79 6" Oak
 S 40° E 5.00 11" Oak

MSHD ref tags set in wit.

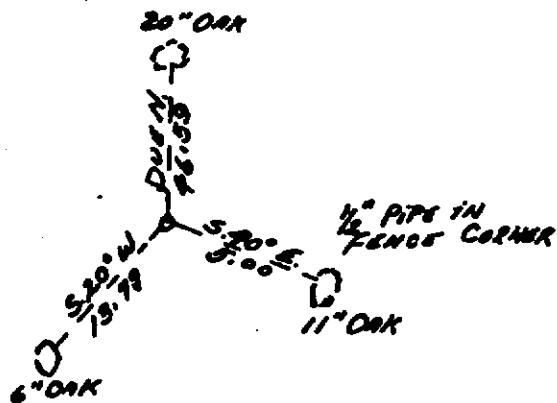

A-7

T. 5 N. R. 8 E. Groveland Twp. Oakland Co. Mich. SEC. 30

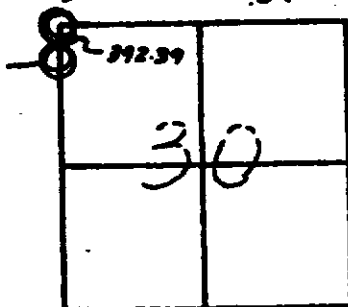

REMARKS

3/4" dia. pipe North edge Grange Hall Ed.


392.39' North of Section Corner common to sections 25 & 24 T 5 N R 7 E.

MSHD Jan. 1959

WITNESSES

N 10° W 25.82 27" Oak
 N 50° E 37.91 Fence Cor.
 S 50° E 59.50 17" Hick.
 N 65° W. 63.65 11" B.E.

MSHD ref. tags set in wit.

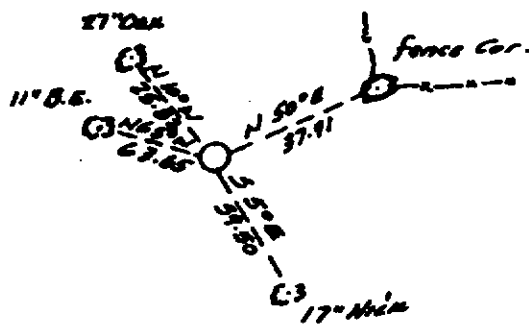

A-8