

MAR 21 2000

LIBER 19758 PG 410

COPY

LAND CORNER RECORDATION CERTIFICATE

SECTION 106224

Filing Requirement of Act 74, Mich. P.A. 1990 19758 PAGE 410

For corners in Oakland (County)

Located In:

Corner Code #

\$7.00 MISC RECORDING \$2.00 REMONUMENTATION 03/30/1999 01:03:21 P.M. RECEIPT# 12968 PAID RECORDED - OAKLAND COUNTY G. WILLIAM CADDELL, CLERK/REGISTER OF DEEDS

Table with 3 columns: Description, Located In (T, S, R), and Corner Code # (A-7). Rows include Public Land Survey, Property Controlling in Section, and Miscellaneous Property in Section.

Compliance with ACT 345, P.A. 1990

APPROVED ON: 3-10-99 JS OAKLAND COUNTY REMONUMENTATION PEER GROUP COMMITTEE

Register of Deeds Stamp & File Number

4. Lot No. Recorded Plat 5. Private Claims

Grid table with columns A-L and rows 2-13. Cell (7,7) is shaded.


I, Timothy J. Hart, in a field survey on 5-11, 19 99, do hereby certify that under requirements of P.A. 74, Michigan P.A. of 1970, the corner points mentioned in lines 1 and 2 above were in conformance with regulations and rules therefore as required in the current manual of survey instructions of the United States Department of the Interior, Bureau of Land Management or by a decree of a Court of Law and/or that the corner points mentioned in lines 3, 4 and 5 above were in conformance with the rules of the Michigan Board of Professional Surveyors or by a Decree of a Court of Law; established, re-established, monumented, re-monumented, recovered, found as expressed below:

NOTE: Not more than 4 corners, all in the same town and range, may be recorded on this certificate.

A. Description of original monument and accessories and/or subsequent restoration:

Post set in 1823 G.L.O. survey on Township line North 9.14 chains (603.24 f) Corner M-7 Holly Township.

- Michigan State Highway Department 1/2" dia. pipe at fence corner, 1-14-59 North 46.59' Nail/MSHD tag 20" Oak S 20°W 13.79' Nail/MSHD tag 6" Oak \*S 40°E 5.00' Nail/MSHD tag 11" Oak

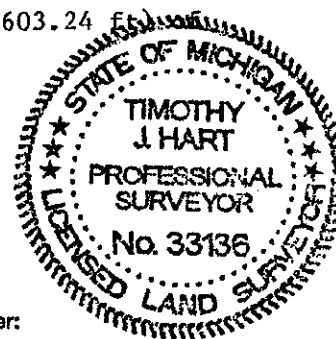

B. Description of corner evidence found and/or method applied in restoring or reestablishing corner:

Recovered a 1/2" pipe 6" below grade on the eastern boundary of a gravel mining area. Recovered a 3/4" pinch top 18" below the 1/2" pipe. A faint tree line with fence remnants runs south and a faint tree line runs north from the corner. Much of the witness and occupational evidence has been destroyed by the mining operation.

Witness Recovered \*S 80°E 5.00' Nail/MSHD tag 14" Oak

\*Confirms LCRC

lp R.

C. Description of monument for corner and accessories established to perpetuate locating the position of the corner:

Set concrete monument with O.C. remonumentation cap, replacing 1/2" pipe.

N 05°E 70.30' PK/remon tag W. 20" Hickory S 80°E 5.00' PK/remon tag N. 14" Oak S 20°W 38.91' PK/remon tag E. 10" Poplar West 16.23' PK/remon tag N. 10" Poplar State Plane Coordinates N 485754.7408 E 13337132.3103

The selected location is accepted by the Contractor and is generally accepted by professional surveyors as the best available evidence of the position of the original corner. This corner was also accepted by the Oakland County Peer Group as established under Act 345 of P.A. 1990.

Signed by Timothy J. Hart Surveyor's Michigan License No. 33136

Date 3-5-99