

COPY

LIBER 19758PG454

106268

LAND CORNER RECORDATION CERTIFICATE PAGE 454
Filing Requirement of Act 74, Mich. P.A. 1990

RECORDING
03/30/1999 01:03:22 P.M. RECEIPT# 12968
PAID - OAKLAND COUNTY
S. WILLIAM CADDELL, CLERK/REGISTER OF DEEDS

For corners in


Oakland (County) Located In: Corner Code #

1. Public Land Survey T5N R8E E-11
T R SURVEY &
T R REDEMPTION
2. Property Controlling S T R
in Section S T R MAR 21 2000
3. Miscellaneous S T R
Property in Sec. S T R SECTION

Compliance with ACT 345, P.A. 1990
APPROVED ON: 11-05-98 JS
OAKLAND COUNTY REMONUMENTATION PEER GROUP COMMITTEE

Register of Deeds Stamp & File Number

4. Lot No. _____, Recorded Plat _____
5. Private Claims _____

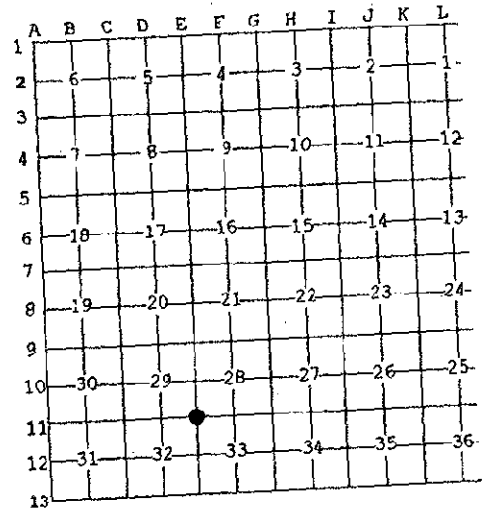

I, Timothy J. Hart, in a field survey on 7-31, 19 98 do hereby state that under requirements of P.A. 74, Michigan P.A. of 1970, the corner points mentioned in lines 1 and 2 above were in conformance with regulations and rules therefore as required in the current manual of survey instructions of the United States Department of the Interior, Bureau of Land Management or by a decree of a Court of Law and/or that the corner points mentioned in lines 3, 4 and 5 above were in conformance with the rules of the Michigan Board of Land Surveyors or by a Decree of a Court of Law; established, re-established, monumented, recovered, found as expressed below:

NOTE: Not more than 2 corners, all in the same town and range, may be recorded on this certificate.

A. Description of original monument and accessories and/or subsequent restoration:
Post set in 1823 G.L.O. survey; 10" W. Oak S 88°E 13 lks; 11" W. Oak S 40°W 14 lks.
Mich. Dept. of Conservation (MDOC), 1962, Oakland County Road Commission
Mich. Dept. of Natural Resources (MDNR), 1969, fd iron w/3" aluminum cap
1966, recovered T iron & replace with *North 12.30' Spike E. 7" Hickory
1" pipe with cap. *East 12.60' Spike N. 5" Cherry
*South 15.68' Spike E. 16" Oak
*N 03°E 11.95' 6" Pignut Hickory
S 84°E 15.05' 4" Pignut Hickory
*S 12°W 15.55' W. Oak

B. Description of corner evidence found and/or method applied in restoring or reestablishing corner:
Recovered 1" pipe with 3" aluminum Michigan Dept. of Conservation cap
at the intersection of old occupation lines. Fence/tree/rock rows run
north, south, east and west from the corner. Corner is located in the
Holly Recreation Area approximately 700 ft east of Dixie Highway.

Witnesses Recovered
*North 12.00' Nail W. 14" Hickory
*N 80°E 12.74' Nail/cap S. 10" Cherry
S 70°E 12.65' Nail/cap S. 8" Hickory
*South 15.70' Nail/cap E. 18" Oak

*Confirms MDOC, MDNR and/or OCRC witnesses
C. Description of monument for corner and accessories established to perpetuate locating the position of the corner:
Accepted 1" pipe with Michigan Dept. of Conservation aluminum cap.

State Plane Coordinates
N 475589.6425
E 13348036.4441
North 12.07' PK/remon tag W. 14" Hickory
N 80°E 12.88' PK/remon tag S. 10" Cherry
S 70°E 12.75' PK/remon tag S. 8" Hickory
South 15.62' PK/remon tag E. 18" Hickory

The selected location is accepted by the Contractor and is generally accepted by professional surveyors as the best available evidence of the position of the original corner. This corner was also accepted by the Oakland County Peer Group as established under Act 345 of P.A. 1990.

Signed by Timothy J. Hart
Surveyor's Michigan License No. 33136

Date 11-4-98

