

COPY

LIBER 19758 PAGE 462

LAND CORNER RECORDATION CERTIFICATE
Filing Requirement of Act 74, Mich. P.A. 1970

106276

For corners in Oakland (County)

Located In:

Corner Code #

LIBER 19758 PAGE 462

\$7.00 MISC RECORDING

\$2.00 REMONUMENTATION

03/30/1999 01:03:22 P.M. RECEIPT# 12968

PAID RECORDED - OAKLAND COUNTY

G. WILLIAM CADDELL, CLERK/REGISTER OF DEEDS

1. Public Land Survey

T 5N R 8E

F-11

T R

T R

T R

S T R

2. Property Controlling in Section

S T R

3. Miscellaneous

S T R

Property in Section

S T R

MAR 21 2000

SECTION

Compliance with ACT 35, P.A. 1990

APPROVED ON: 1-27-99 JS OAKLAND COUNTY REMONUMENTATION PEER GROUP COMMITTEE

Register of Deeds Stamp & File Number

4. Lot No. Recorded Plat

5. Private Claims

Grid table with columns A-M and rows 2-13. A dot is marked at row 11, column G.


I, Timothy J. Hart, in a field survey on 11-13, 19 98, do hereby certify that under requirements of P.A. 74, Michigan P.A. of 1970, the corner points mentioned in lines 1 and 2 above were in conformance with regulations and rules therefore as required in the current manual of survey instructions of the United States Department of the Interior, Bureau of Land Management or by a decree of a Court of Law and/or that the corner points mentioned in lines 3, 4 and 5 above were in conformance with the rules of the Michigan Board of Professional Surveyors or by a Decree of a Court of Law; established, re-established, monumented, re-monumented, recovered, found as expressed below:

NOTE: Not more than 4 corners, all in the same town and range, may be recorded on this certificate.

A. Description of original monument and accessories and/or subsequent restoration:

Post set in 1823 G.L.O. survey; no bearing trees.

No record of subsequent restoration.

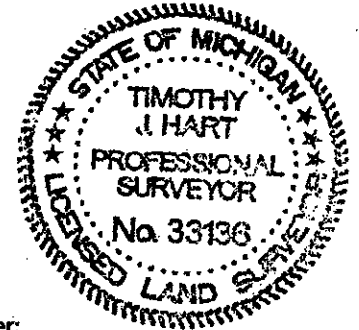

B. Description of corner evidence found and/or method applied in restoring or reestablishing corner:

Corner falls in Valley Lake, located in the Holly Recreation Area. The corner position was calculated at the midpoint of the straight line between corners E-11 and G-11. A reference monument was set 154 feet± west of the west shore of Valley Lake, falling on an east-west rock/tree occupation line. The reference monument was set on the section line 882.20 feet west of corner F-11 in the Valley Lake picnic area on the east edge of a trail located on the top bank overlooking the lake.

C. Description of monument for corner and accessories established to perpetuate locating the position of the corner:

Set concrete monument with O.C. remonumentation brass disc at reference point location on the section line 882.20 feet west of corner F-11.

N 25°W 64.48' PK/remon tag W. 24" Oak

East 50.22' PK/remon tag N. 42" Oak

South 18.42' PK/remon tag W. 40" Oak

S 85°W 5.98' PK/remon tag N. 24" Cherry

State Plane Coordinates (F-11)

N 475696.7632

E 13350666.6587

The selected location is accepted by the Contractor and is generally accepted by professional surveyors as the best available evidence of the position of the original corner. This corner was also accepted by the Oakland County Peer Group as established under Act 345 of P.A. 1990.

Signed by Timothy J. Hart, Surveyor's Michigan License No. 33136

Date 1-23-99